

Name

Service No.

Address 95-97 BEDFORD ST.

Mc MAUGLIN

Location

Kind of Pipe

Size

Size of Main

Repair—Renewal—New Service

Location

Date

Material

Amount

Total

Date

Amount


8-8-2014

18'-6" PVC

DATE 8/8/2014

TOWN OF LEXINGTON — BOARD OF PUBLIC WORKS  
SEWER DIVISION

Sketch of Service Here

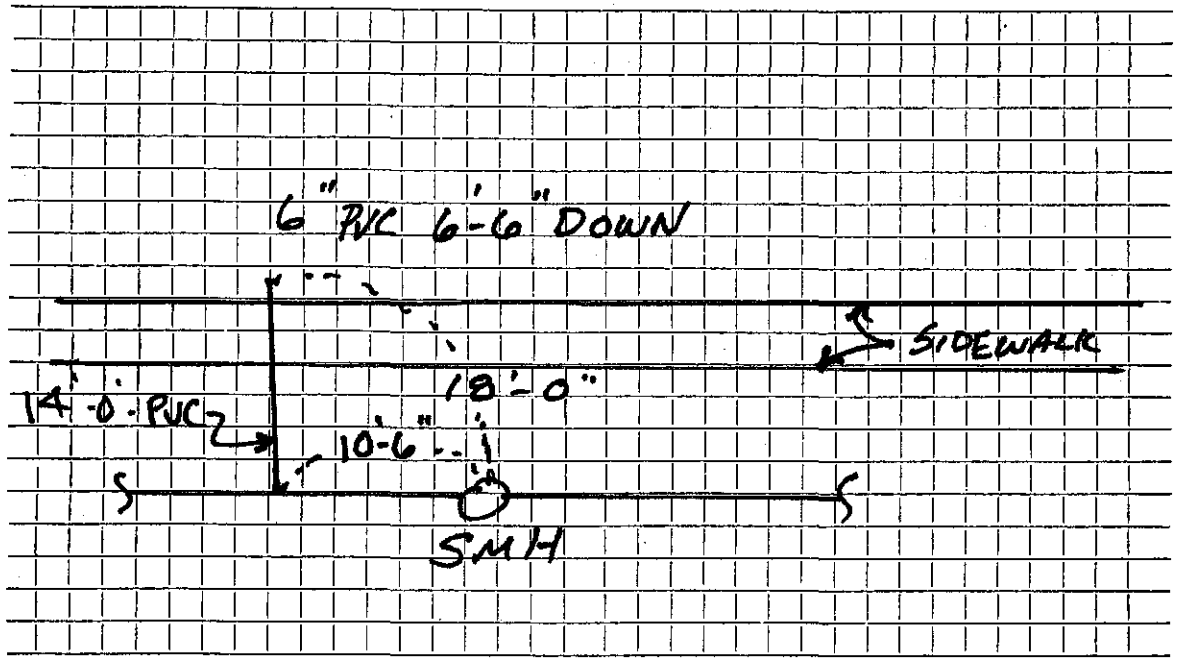

Connection made in ..... Street. Work completed .....

Remarks: .....  
.....  
.....