

Name William S. Barker Bill: Lexington Savings Bank

Service No. 20 75

Address ⁹⁸~~65~~ Bedford Street

Location

Kind of Pipe

Size

Size of Main

~~Repair - Renewal~~ - New Service

Location

Hadley Press, Inc., Lexington

Date	Material	Amount	Total	Date	Amount
8/13/	40' 6" Sewer Pipe @ .15	\$6 00			
<i>11-27-34 Com. 57.76 to Russell</i>	10' 4" Iron Pipe @ .75	7 50			
	Sulphur & Jute	1 40			
	Trucking	75	\$15 85		
	16 Hrs. Labor @ .50	8 00			
	46 " " @ .55	25 30			
	8 " " @ .60	4 80	38 10		
	10% Overhead		3 81		
			57 76		
	Labor				

TOWN OF LEXINGTON—BOARD OF PUBLIC WORKS

SEWER DIVISION

DATE Aug 9 1934

NO. _____


The undersigned applies for the construction of a particular sewer connecting No. 68 Bedford Street and hereby agrees to comply with the Rules and Regulations governing the construction and use of Particular Sewers, as now or at any future time established by the Board of Selectmen.

Am't. of Estimate \$ 120-

Am't. Paid \$ _____

Wm. S. Barker Owner

Sketch of Service Here

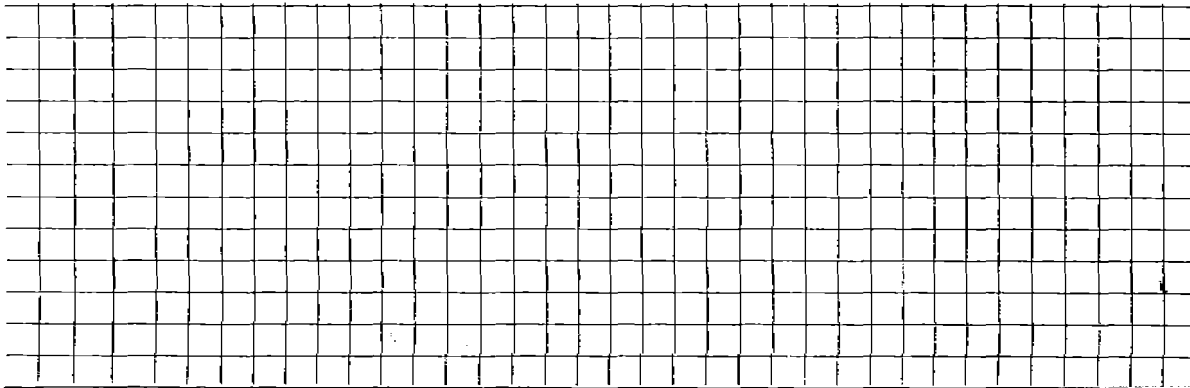

Connection made in _____ Street. Work completed _____ 19

Remarks: