


TOWN OF LEXINGTON — BOARD OF PUBLIC WORKS

SEWER DIVISION

Sketch of Service Here

BEDFORD ST

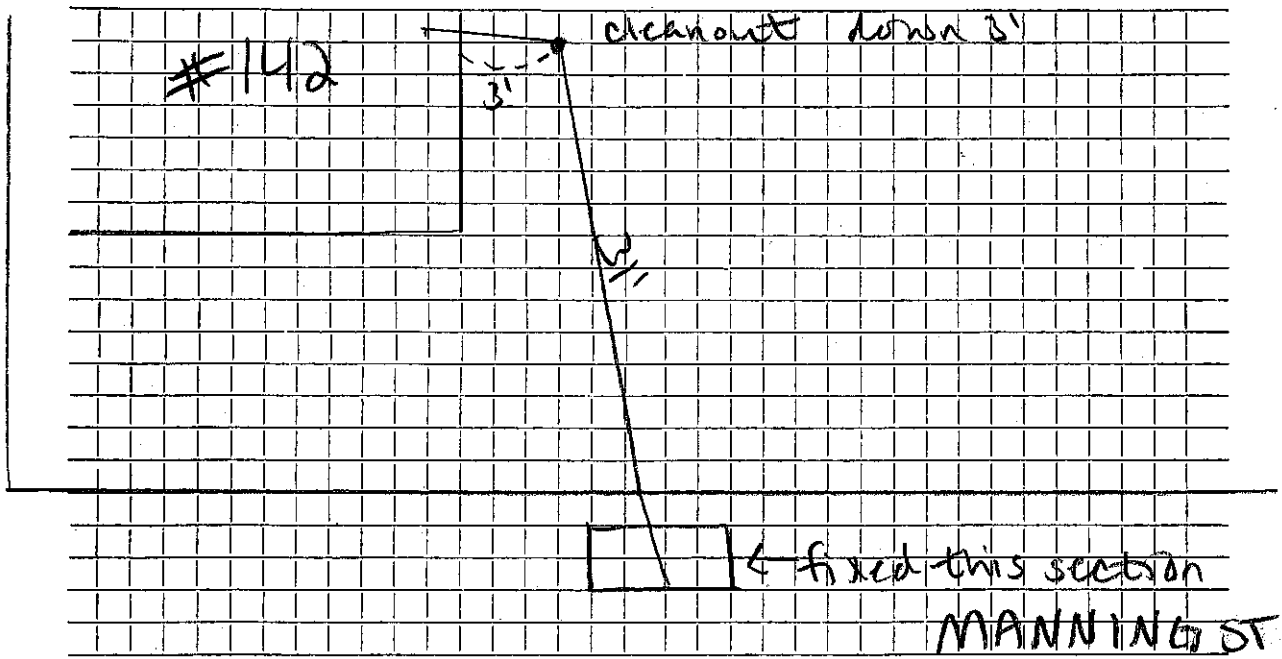

Connection made in Manning St Street. Work completed

Remarks: broken pipe in Manning St just before main