

Name

Service No.

Address

186 Bedford St

Location

Kind of Pipe

SDR35 PVC

Size

6" x 8"

Size of Main

Repair—Renewal—New Service

Location

Date

Material

Amount

Total

Date

Amount

SMH in street

8" PVC pipe

78'

SMH on property

to BARN:

6" SDR35 PVC

6" cleanout


to #186 Bedford

6" SDR35 PVC

6" cleanout

6"-22 1/2° bend

# TOWN OF LEXINGTON — BOARD OF PUBLIC WORKS SEWER DIVISION

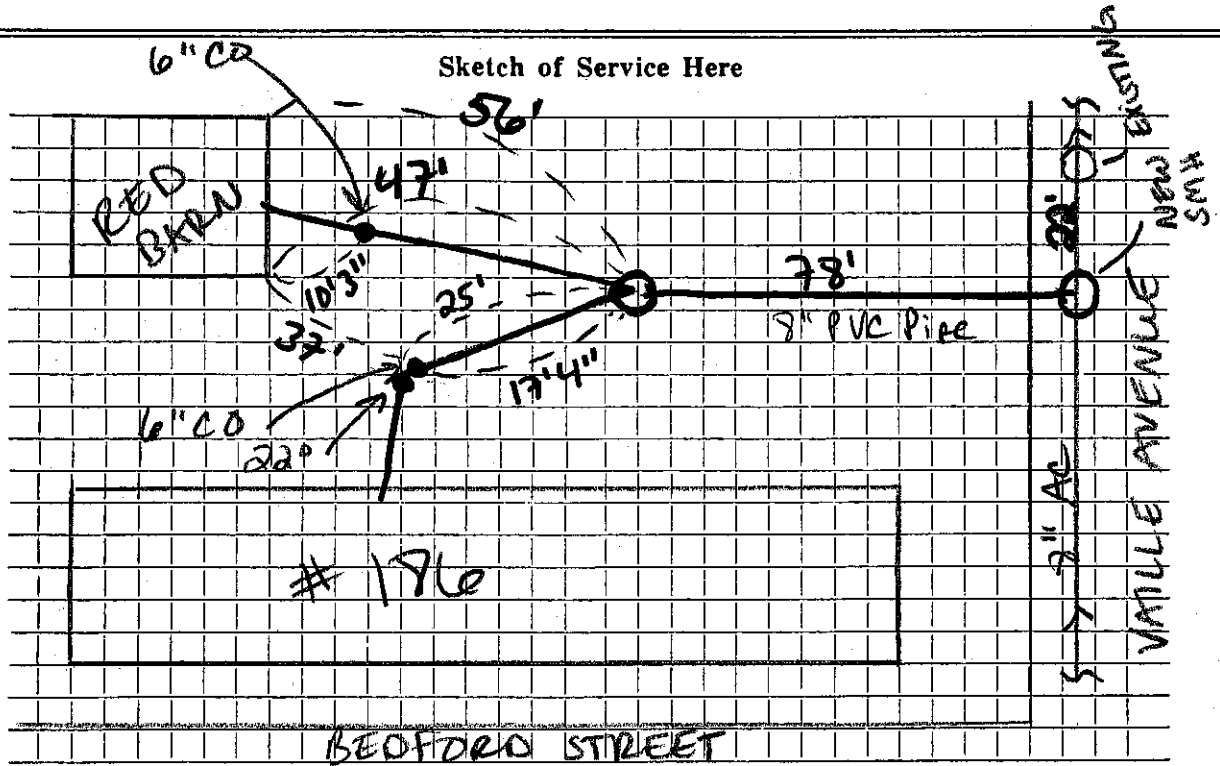

Connection made in ... Vaille Ave (unaccepted way) Street

Work completed .....

Remarks: