




DATE 11/5/19

TOWN OF LEXINGTON — BOARD OF PUBLIC WORKS

SEWER DIVISION

#'s 193-195

Sketch of Service Here

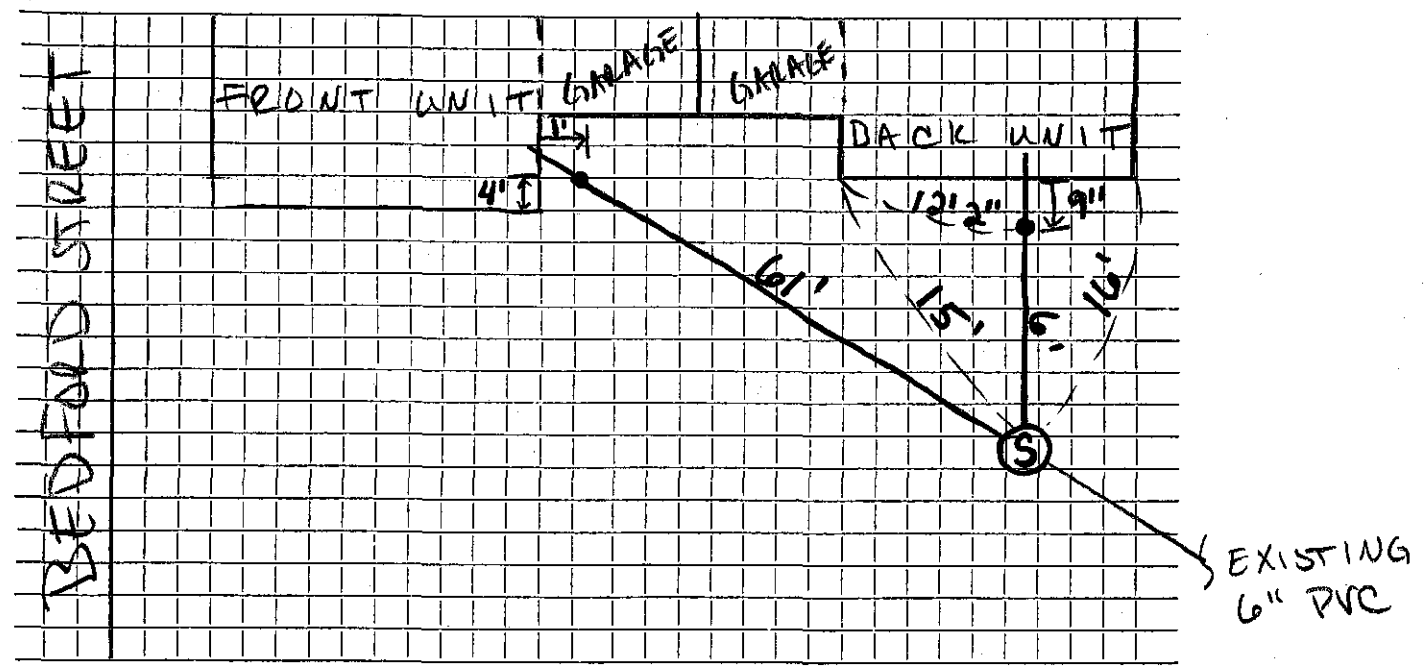

Connection made in ..... Street. Work completed .....

Remarks: Both cleanouts are 4" Sch. 40  
New SMH