




DATE 7/11/19

TOWN OF LEXINGTON — BOARD OF PUBLIC WORKS  
SEWER DIVISION

Sketch of Service Here

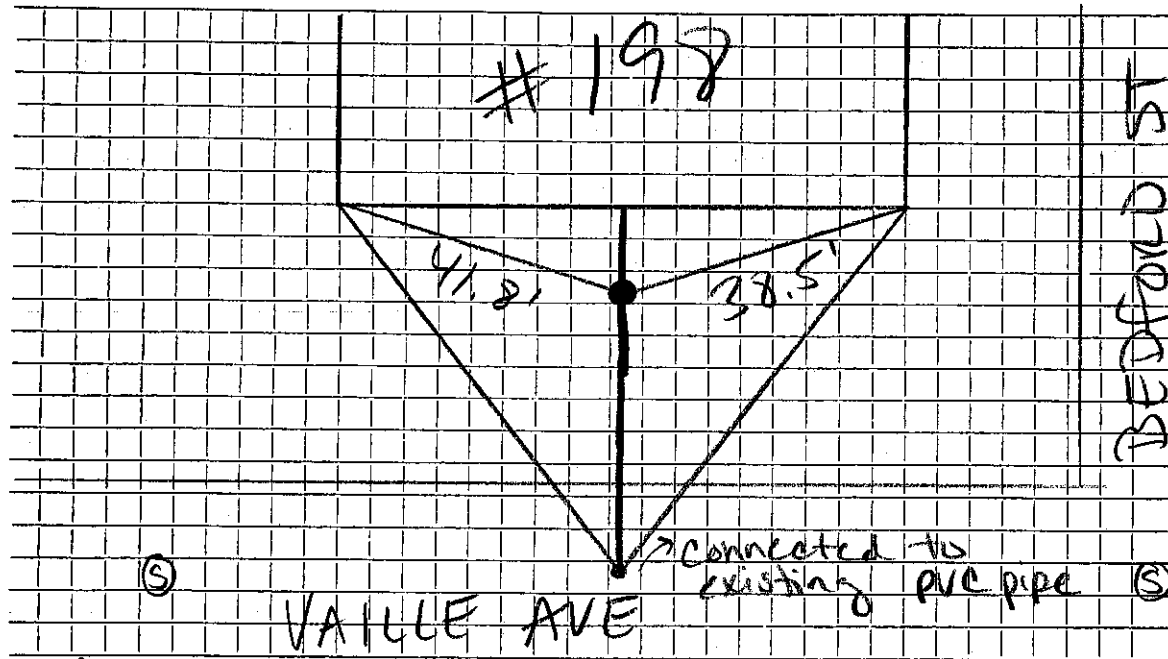

Connection made in Vaillle Ave Street. Work completed .....

Remarks: Connected to existing PVC stub in line with sewer Manholes