

Name Claude L. Patterson

Service No. 61

Address 10 Belfry Terrace

Location

Kind of Pipe

Size

Size of Main

~~Repair~~ ~~Renewal~~ ~~New Service~~ W.O.#2332

Location


SEP 19 1966

Date	Material	Amount	Total	Date	Amount
5-19-66	Labor	70 50		5-12-66	150 00
	10% O.H.	7 05	77 55	9-19-66	14 50
40'	6" Transite pipe @ .88		35 20		135 46
1	Bag Cement		1 55		
2	Doz Brick @ 4.20 per 100		1 02		
2	Yards Loam @ 3.00		6 00		
2	Lbs Grass seed @ 1.05		2 10		
4	Hrs Town Truck @ 3.00		12 00		
			135 42		

DATE _____

TOWN OF LEXINGTON — BOARD OF PUBLIC WORKS
SEWER DIVISION

Sketch of Service Here

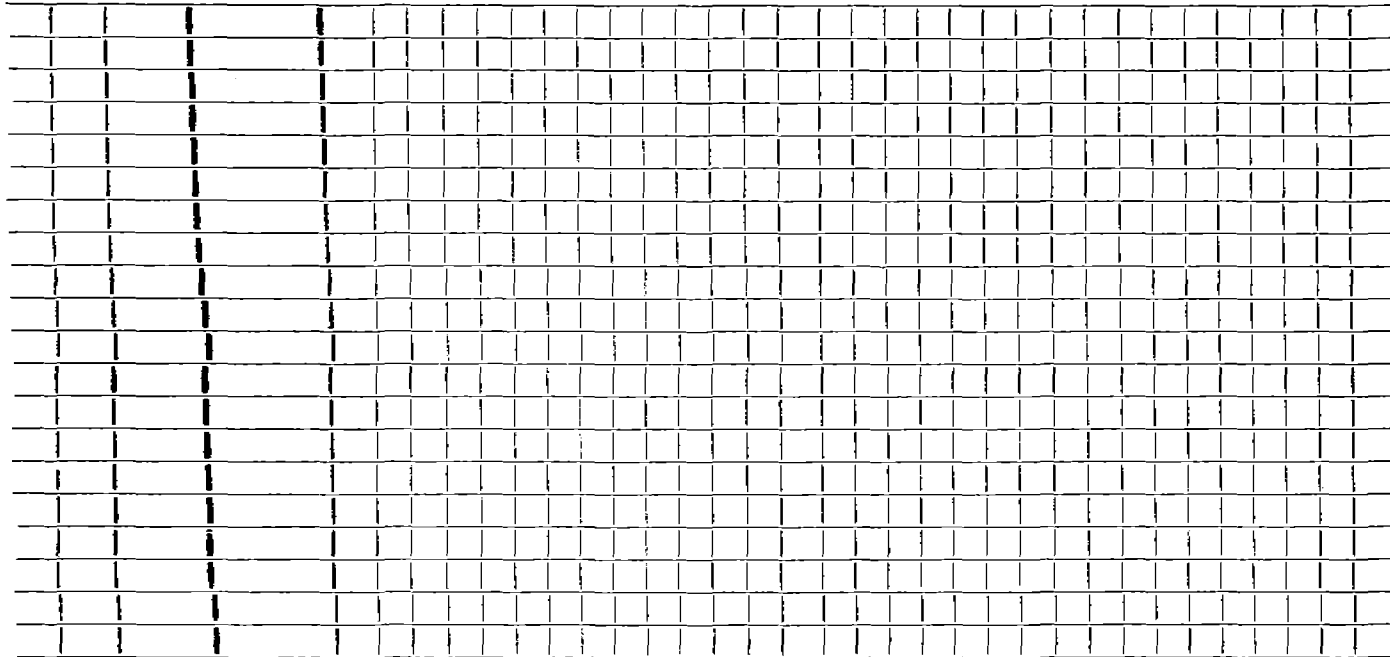

Connection made in Street. Work completed

Remarks: *Original* - *Service 5-24-32*

.....
.....

