




DATE \_\_\_\_\_

TOWN OF LEXINGTON — BOARD OF PUBLIC WORKS

SEWER DIVISION

Sketch of Service Here

11

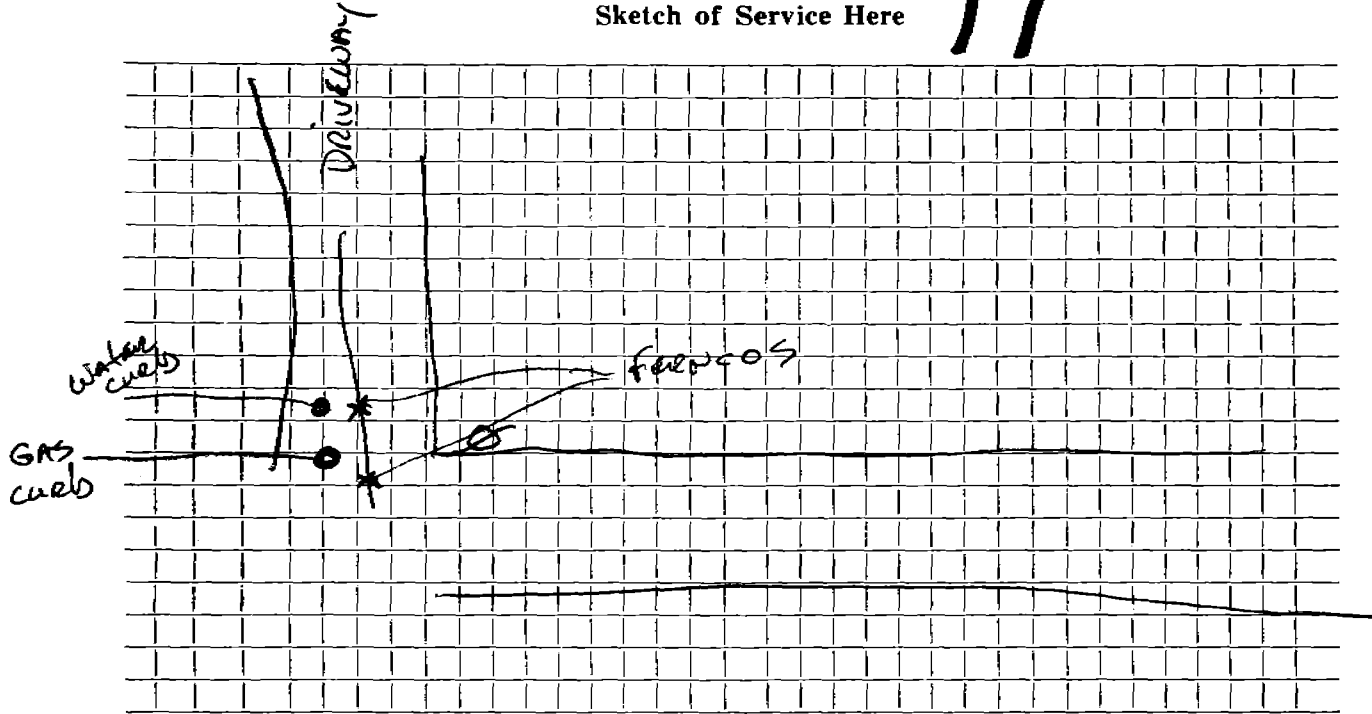

Connection made in BEAVERY TERR. Street. Work completed ?

Remarks: NOT INFORMATION ON THIS SERVICE. DEFINITELY HOOKED UP TO SEWER Sewer to right of gas and water facing up the driveway — Gas main just off edge of land