

Name Paul Whipple

Service No. 7 80

Address 15 Belfry Terrace

Location Same

Kind of Pipe

Size

Size of Main

~~Repair~~ ~~Renewal~~ New Service

Location

Date	Material	Amount	Total	Date	Location	Amount
1935	52 hrs. labor @ 55¢	28 60		1935	Deposited	35 -
May 18	10% Ovhd. on labor	2 86		May 14		
<i>Comm. 5/17/35 9.35.00 to Russell</i>	34' 6" S. Pipe @ 17¢	5 78				
	Joint. Comp.	22				
	Trucking	<u>1 50</u>				
			\$38 96			
	Say: \$35.00					
	Labor					

Hadley Press, Inc., Lexington

TOWN OF LEXINGTON—BOARD OF PUBLIC WORKS  
SEWER DIVISION

DATE May 13, 1935.

NO. \_\_\_\_\_

The undersigned applies for the construction of a particular sewer connecting No. 15 Belfry Terrace Street and hereby agrees to comply with the Rules and Regulations governing the construction and use of Particular Sewers, as now or at any future time established by the Board of Selectmen.


Am't. of Estimate \$ 35.00 (Original: See letter)

Am't. Paid \$ \_\_\_\_\_

Paul Phipple Owner

Sketch of Service Here

**15**

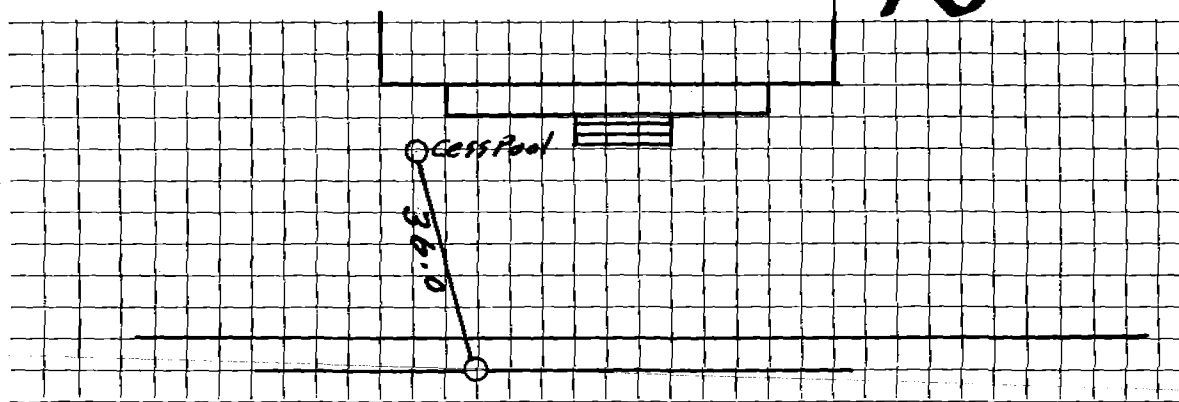

Connection made in \_\_\_\_\_ Street.

Work completed \_\_\_\_\_ 19

Remarks: