

Name M. Bowman Judkins  
 Address Grassland Street

Service No. 981

Location <sup>#16</sup> Cook house on Belfry Terrace

Kind of Pipe Size Size of Main

~~Repair - Renewal~~ New Service

Location

Date	Material	Amount	Total	Date	Amount
1935					
June 3 <i>Com. to Russell 6-18-35 - 8-18-55</i>	3 Hrs. Labor @ 55¢	1 65		<i>May 29 Deposited</i>	<i>35 50</i>
	3 " " @ 60¢	1 80	3 45	<i>June 19, 1935 Refunded</i>	<i>16 95</i>
	10% Overhead		35		<i>18 55</i>
	65' 6" Sewer Pipe @ 20¢	13 00			
	Sulphur & Jute	75			
	Trucking	1 00	14 75		
			18 55		
	Labor			<i>3/5/69</i>	<i>Repair exp.</i>

Hadley Press, Inc., Lexington

TOWN OF LEXINGTON—BOARD OF PUBLIC WORKS

SEWER DIVISION

DATE May 28, 1935.

NO. 09

The undersigned applies for the construction of a particular sewer connecting No. Betty Terrace Street and hereby agrees to comply with the Rules and Regulations governing the construction and use of Particular Sewers, as now or at any future time established by the Board of Selectmen.


Am't. of Estimate \$ 35.50

Am't. Paid \$ \_\_\_\_\_

Chester S. Cook Owner  
Per W.B. Judkins, Cont.

Sketch of Service Here

**16**

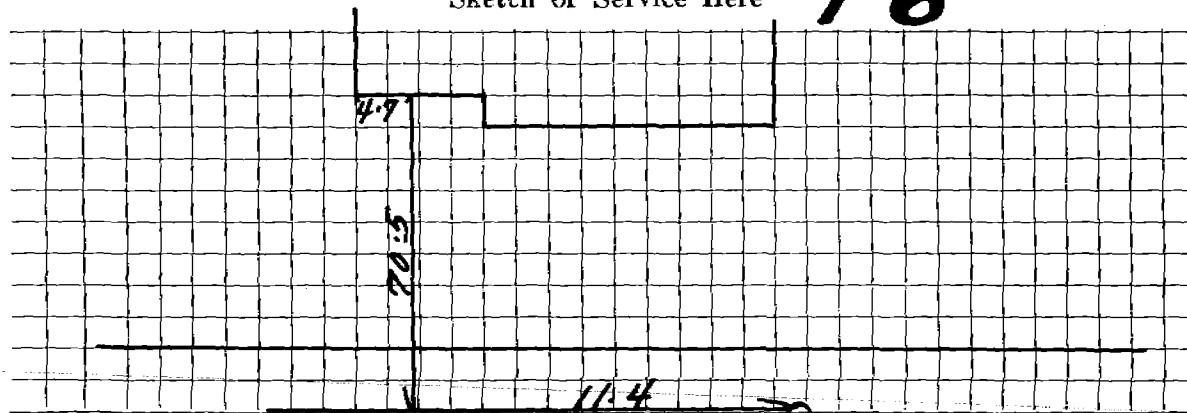

Connection made in \_\_\_\_\_ Street.

Work completed \_\_\_\_\_ 19

Remarks: