

Name Rodney W. Long Housing Corp.

Service No. 16 82

Address 18 Brattle Street, Cambridge, Mass.

Location 18 Belfry Terrace, Lexington

Kind of Pipe

Size

Size of Main

~~Repair-Renewal~~—New Service

Location

Date	Material	Amount	Total	Date	Amount
1936				1936	
Aug. 18	16 hrs. labor @ 60¢	9 60		Aug. 15	50 00
Com. 4/15/36 to Russell \$50.00	12 " " @ 55¢	6 60	16 20	Sept. 22	20 00
	10% Ovhd. on labor		1 62		30 00
	50' 6" Sewer Pipe @ 16¢	8 00			
	1 1/8 6" Bend	65			
	Jointing Comp.	2 60			
	Trucking	1 00	12 25		
			30 07		
	Say: 50' @ 60¢		30 00		
	Labor				

Hadley Press, Inc., Lexington

TOWN OF LEXINGTON—BOARD OF PUBLIC WORKS
SEWER DIVISION

DATE _____

NO. _____

The undersigned applies for the construction of a particular sewer connecting No. 18 Balfry Terrace
~~Street~~ and hereby agrees to comply with the Rules and Regulations governing the construction and use of Particular
Sewers, as now or at any future time established by the Board of Selectmen.


Am't. of Estimate \$ _____

Am't. Paid \$ _____

Raduz W. Long Housing Corp. Smith
By Dan A. [Signature] Owner

Sketch of Service Here

18

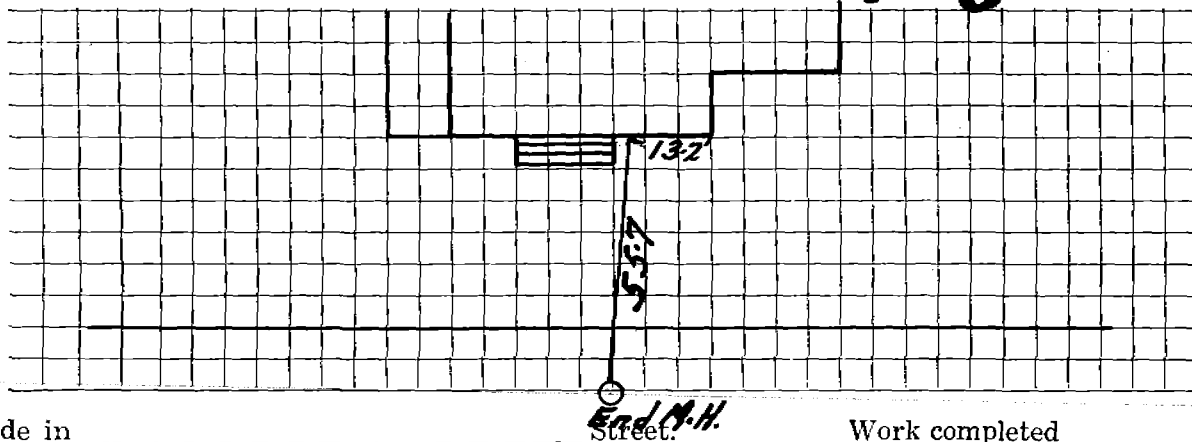

Connection made in _____

End N.H.
Street.

Work completed _____ 19

Remarks: