

Name Stankard

Service No. 21

Address

5 + 7 Belfry Terrace

Location 5 & 7 Belfry Terrace

Kind of Pipe

Size

Size of Main

Repair—Renewal—New—Service

Location

Date	Material	Amount	Total	Date	Amount
Sept. 9, '44	Non-Charge Labor	16 80			
" 27, '44	"	17 90	34 70		
	10% Overhead		3 47		
	36' 6" Sewer Pipe @.22		7 92		
	1- 6" $\frac{1}{4}$ Bend		67		
	Joint Compound		2 16		
	Trucking 1 hr. @.75		75		
	Comp. 1 hr. @1.75		1 75		
			51 42		
	Labor				

TOWN OF LEXINGTON—DEPT. OF PUBLIC WORKS

SEWER DIVISION

DATE


NO.

The undersigned applies for the construction of a particular sewer connecting No. Street and hereby agrees to comply with the Rules and Regulations governing the construction and use of Particular Sewers, as now or at any future time established by the Board of Selectmen.

Am't of estimate \$.....

Am't Paid \$.....

..... Owner

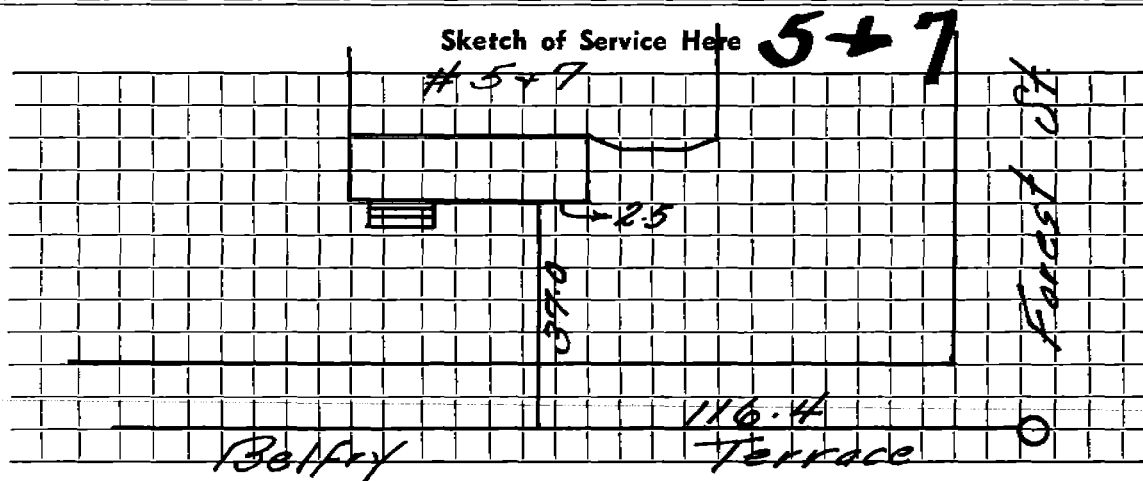

Connection made in Street.

Work completed 19..

Remarks: Original Service 7-13-29