

Name Blair Perry

Service No. 131

Address # 11 BELLFLOWER ST. LOTS 25-27

Location

Kind of Pipe

Size

Size of Main

~~Repair Renewal~~ New Service W.O. #9378


Location FEB 15 1965

Date	Material	Amount	Total	Date	Amount
7-29-61	Labor	47.82		8-17-64	Deposit 235.00
	10% O.H.	4.78	52.60	3-17-65	Paid 17.85
	19' 6" Transite pipe @.78		14.82		242.94
	3 Hrs. Town Shovel @6.50		19.50		
	2 Hrs. Trucking @3.00		6.00		
	BILL WHEN CONNECTED		92.92		
12-1-64	Labor	71.06			
	10% O.H.	7.11	78.17		
	35' 6" Transite pipe @ .82		28.70		
	1 Duplex Adapter		2.06		
	1 1 1/4 Bend		4.09		
	3 Yds Loam @ 3.00		9.00		
	2 Hrs Town Shovel @ 6.50		13.00		Bill sent 17.85
	2 Hrs Town Truck @ 3.00		6.00	1 Hr. Compressor	5.00
	1 Hr. Loader		4.00		150.02

DATE _____

TOWN OF LEXINGTON — BOARD OF PUBLIC WORKS
SEWER DIVISION

Sketch of Service Here //

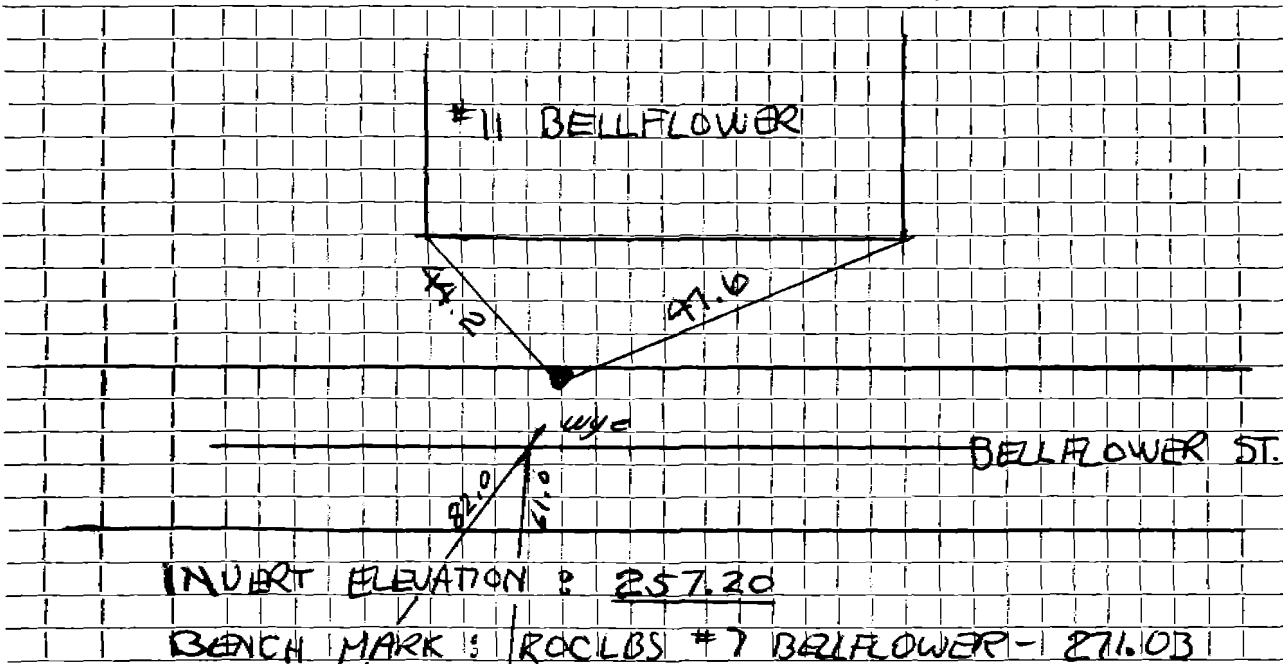

Connection made in Street. Work completed

Remarks:
.....
.....