

Name Richard I. Jones

Service No. 267

Address 12 Bellflower Street

Location

Kind of Pipe

Size

Size of Main

~~REPAIR WORK~~ New Service

Location


Comm 12-31-6

Date	Material	Amount	Total	Date	Amount
12-5-60	Labor 104.63	1		11-28-60	Deposit 200.00
12-6-60	" 41.10	145.73		4-25-61	Paid 60.00
	10% O.H.	14.57	160.30		260.00
	45' 6" Transite pipe @.78		35.10		
	5½ ton ¾" Stone @1.50		8.25		
	2 11¼" Transite Elbow @2.24		4.48		
	1 22½" Transite Bend		6.21		
	1 6" Duplex Adapter		1.90		
	1 6" Clay Elbow		1.88		
	3 hrs. Town Shovel @6.50		19.50		
	5 hrs. Trucking @3.00		15.00		
	2 hrs. Pump @1.00		2.00		
	1 hr. Trailer @3.00		3.00		
	1 hr. Loader @3.00		3.00		
			260.62		

DATE \_\_\_\_\_

TOWN OF LEXINGTON — BOARD OF PUBLIC WORKS  
SEWER DIVISION

Sketch of Service Here **12**

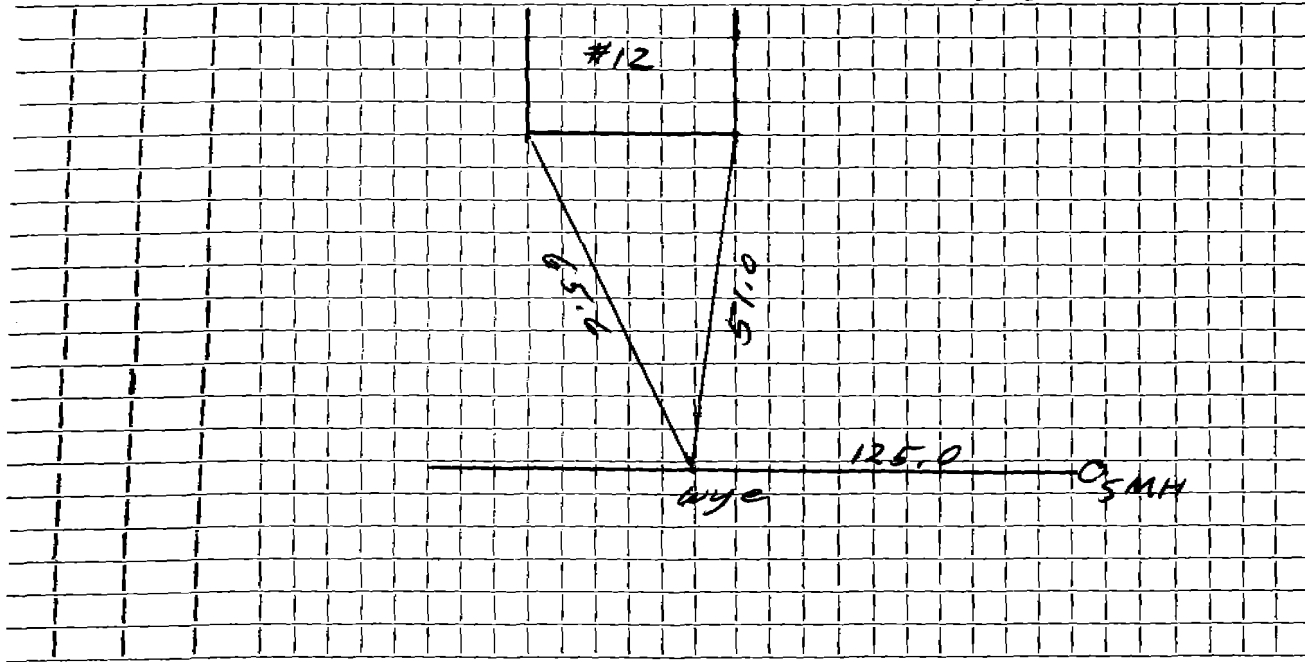

Connection made in \_\_\_\_\_ Street. Work completed \_\_\_\_\_

Remarks: \_\_\_\_\_  
\_\_\_\_\_  
\_\_\_\_\_