

Name Donna Realty

Service No. 160

Address #15 BELLFLOWER ST LOTS 28, 29

Location

Kind of Pipe

Size

Size of Main

Repair—Renewal—New Service

Suburbanite Cesspool

A 495

Location

Comm 5-8-67


Date	Material	Amount	Total	Date	Amount
7-31-61	Labor	44.34		11-30-66	82.59
	10% O.H.	4.43	48.77		
	19' 6" Transite pipe @.78		14.82		
	2 Hrs. Town Shovel @6.50		13.00		
	2 Hrs. Trucking @3.00		6.00		
	BILL WHEN CONNECTED		82.59		
12/13/66	27' 6" Transite				
	10' 4" Cast Iron				

DATE _____

TOWN OF LEXINGTON — BOARD OF PUBLIC WORKS
SEWER DIVISION

Sketch of Service Here

15

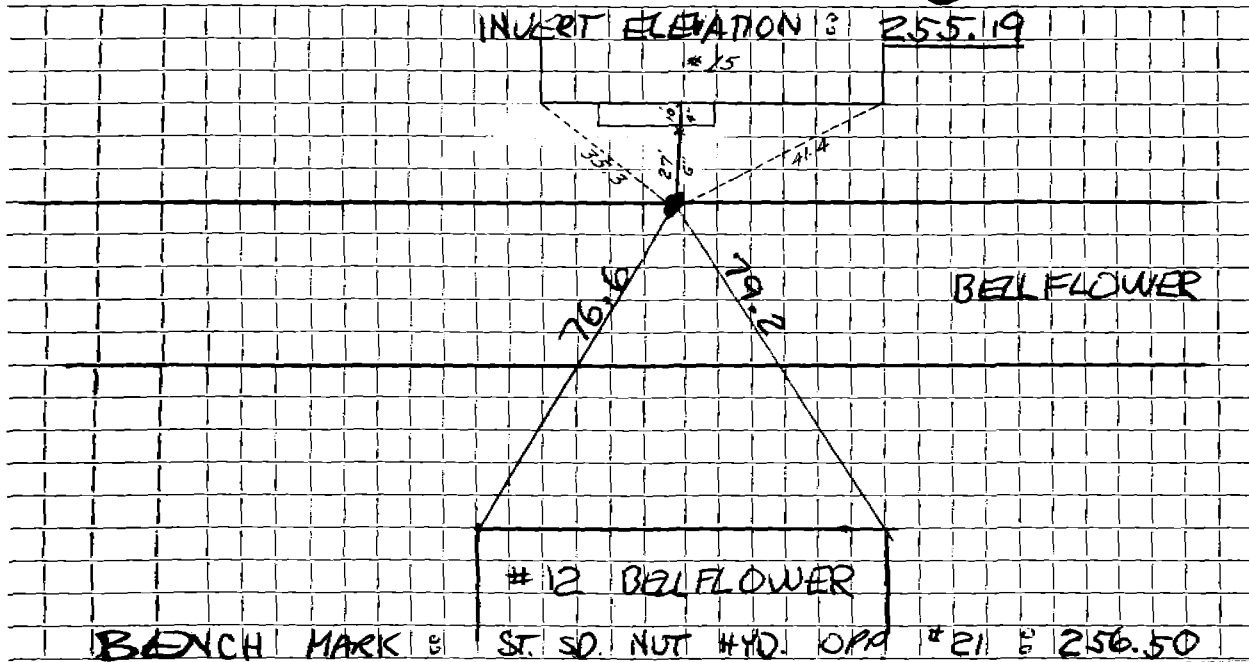

Connection made in Street. Work completed

Remarks:

.....

.....