

Name Clark Hamlet

Service No. 111

Address #16 BELLEFLOWER ST. LOTS 506-510

Location

Kind of Pipe

Size

Size of Main

~~Repair - Rework~~ New Service Valeri #A412


Location OCT 3 1966

Date	Material	Amount	Total	Date	Amount
7-29-61	Labor	47 90		8-16-66	87 23
	10% O.H.	4 79	52 69		
	13' 6" Transite pipe @.78		10 14		
	1 6" 90° Transite Elbow		5 40		
	2 Hrs. Town Shovel		13 00		
	2 Hrs. Trucking @ 3.00		6 00		
	BILL WHEN CONNECTED		87 23		
8/23/66	34' 6" Transite pipe				

DATE 10/21/59

TOWN OF LEXINGTON — BOARD OF PUBLIC WORKS
SEWER DIVISION

Sketch of Service Here **16**

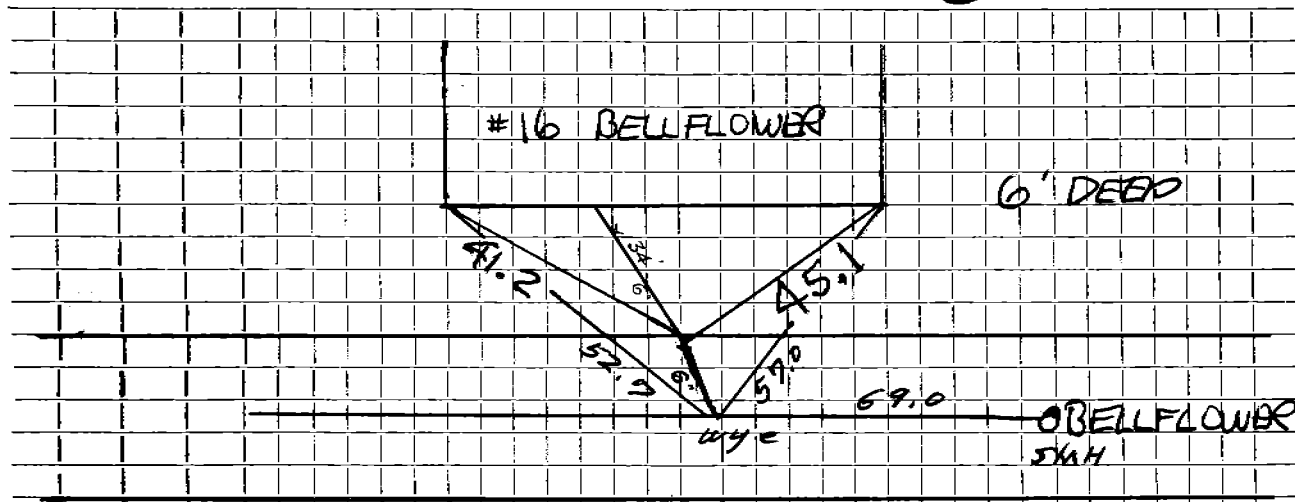

INVERT ELEVATION : 254.48

BENCH MARK : ~~ROCK~~ # 16 BELLFLOWER ? 267.51
ROCKS

Connection made in Street. Work completed

Remarks:
.....
.....