

Name Leon Cormier & Sons, Inc.

Service No. 233

Address 19 Bellflower Street

Location

Kind of Pipe

Size

Size of Main

~~Repair~~ ~~Renewal~~ - New Service

Location *Comm 2-8-60*


Date	Material	Amount	Total	Date	Amount
12-1-59	Labor	53 90		11-16-59	Deposit 150 00
	10% O. H.	5 39	59 29	1-8-60	* Retard 20 00
	71' 6" Transite pipe @.70		49 70		129 30
	1 11 1/2° Transite bend		5 10		
	2 Hrs. Town shovel @6.50		13 00		
	3 Hrs. Trucking @.75		2 25		
			129 34	8-26-02	Respond + Measure
				1-27-75	S.B. (Brick from M.H. d. Solids
					* Applied to 5-11-75 #239

DATE 11/30/59

**TOWN OF LEXINGTON — BOARD OF PUBLIC WORKS**  
**SEWER DIVISION**

Sketch of Service Here

**19**

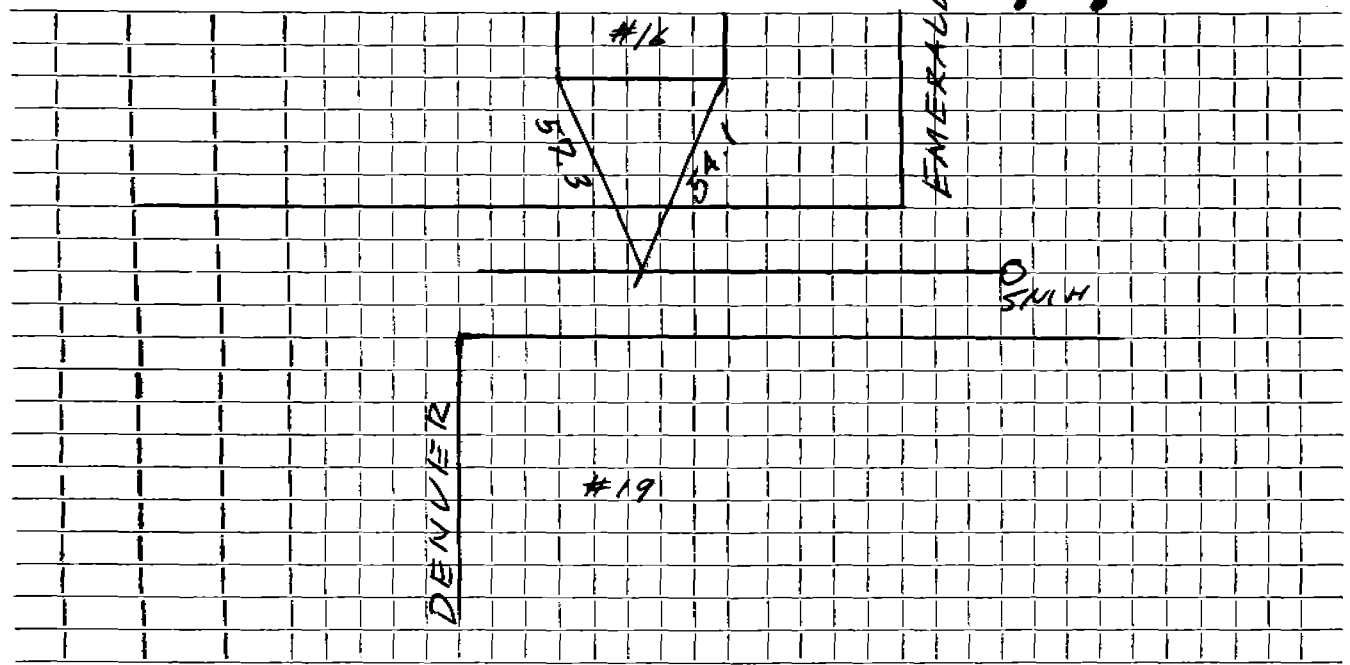

Connection made in ..... Street. Work completed .....

marks: .....

.....  
.....