

Name Leo M. McSweeney

Service No. 147

Address 24 Bellflower Street

Location

Kind of Pipe

Size

Size of Main

~~Rough~~ ~~General~~ ~~New Service~~

Location

Corner 11-16-59


Date	Material	Amount	Total	Date	Amount
9-10-59	Labor	100.32		8-24-59	200.00
	10% O.H.	10.03	110.35	11-16-59	1.63
72	6" Transite pipe @.70		50.40		198.37
1	6" Clay Elbow		1.88		
1	1 1/4" 6" Transite Elbow		2.24		
4	hrs. Town Shovel @6.50		26.00		
1	hr. Trucking @3.00		3.00		
1	hr. Rodgers Trailer @3.00		3.00		
2	hrs. Trucking @.75		1.50		
			198.37		

DATE _____

TOWN OF LEXINGTON — BOARD OF PUBLIC WORKS
SEWER DIVISION

Sketch of Service Here

24

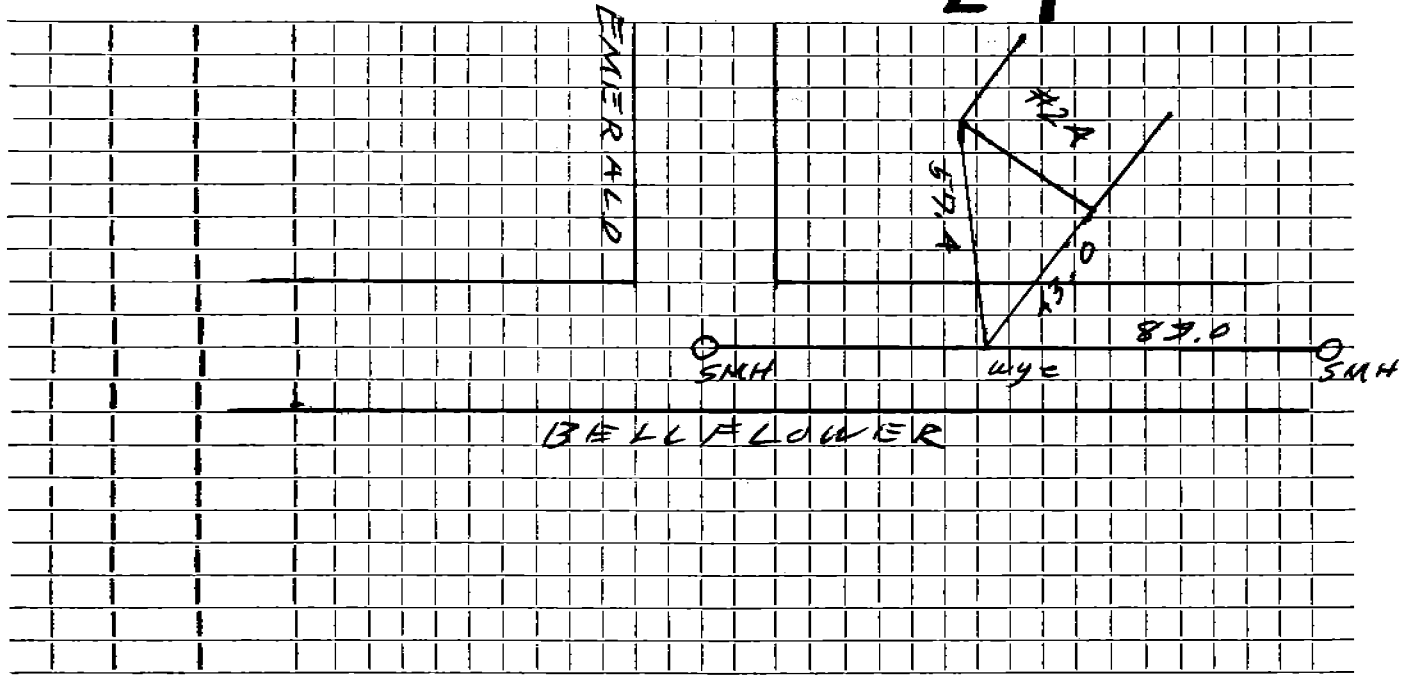

Connection made in Street. Work completed

Remarks: