

Name J & B Realty Trust

Service No. 150

Address # 28 BELLFLOWER ST. LOTS 598-600

Location

Kind of Pipe

Size

Size of Main

Repair—Renewal—New Service Edward Shaw Permit #471

Location


SEP 27 1965

Date	Material	Amount	Total	Date	Amount
7-31-64	Labor	30.92		8-30-65	71.67
	10% O.H.	3.09	34.01		
	17' 6" Transite pipe @.78		13.26		
	1 6" 90° Transite Elbow		5.40		
	2 Hrs. Town Shovel @6.50		13.00		
	2 Hrs. Trucking @3.00		6.00		
	BILL WHEN CONNECTED		71.67		
9-1-65	25' 6" Transite pipe				

DATE \_\_\_\_\_

TOWN OF LEXINGTON — BOARD OF PUBLIC WORKS  
SEWER DIVISION

Sketch of Service Here **28**

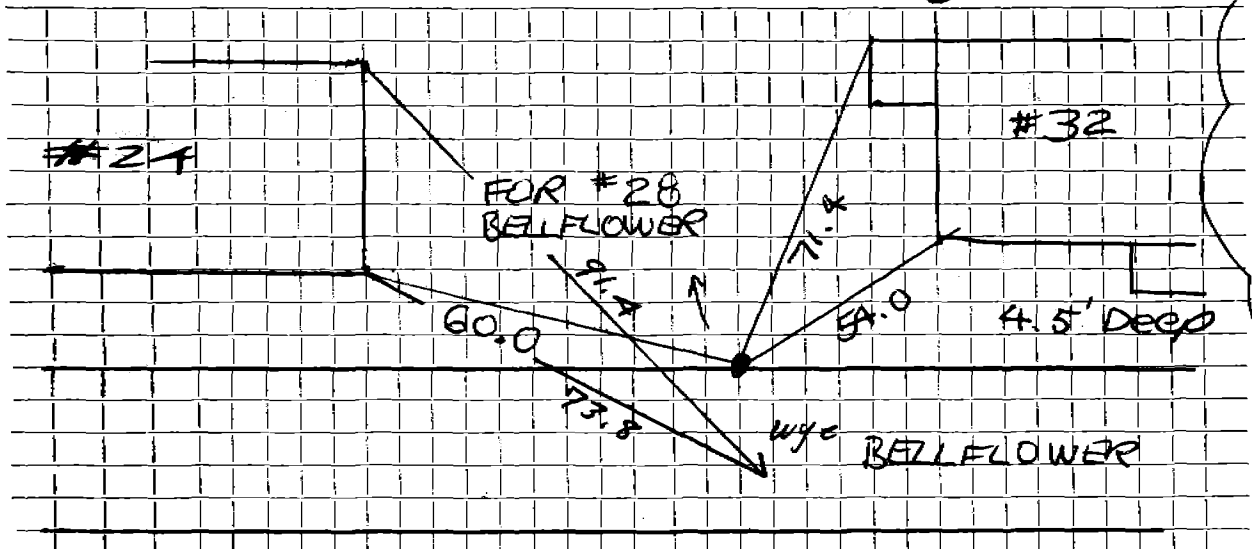

INVERT ELEVATION : 246.91  
BENCH MARK : ST SIDE NOT HYD COP # 21 256.50

Connection made in ..... Street. Work completed .....

Remarks: .....  
.....  
.....