

Name

Service No.

Address

BELLFLOWER ST

Lots 64-68

Location

Kind of Pipe

Size

Size of Main

Repair—Renewal—New Service

Location

Date

Material

Amount

Total

Date

Amount

10-11-60

74' 6" Transite

1 6" Transite Elbow

2 1 1/4" Transite Bend

9-16-75 Roots


9-21-73 Roots

DATE \_\_\_\_\_

TOWN OF LEXINGTON — BOARD OF PUBLIC WORKS  
SEWER DIVISION

Sketch of Service Here

**33**

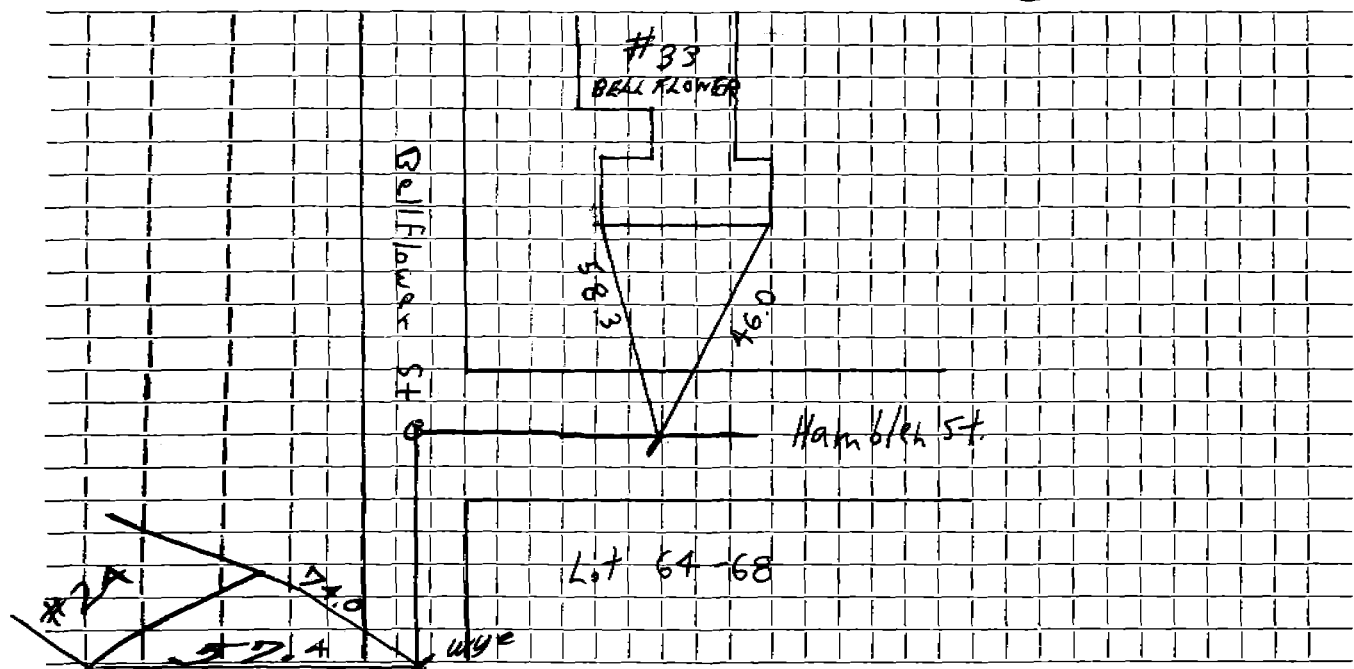

Connection made in ..... Hambleh ..... Street. Work completed .....

Remarks: .....

.....