


DATE _____

TOWN OF LEXINGTON — BOARD OF PUBLIC WORKS

SEWER DIVISION

Sketch of Service Here

48

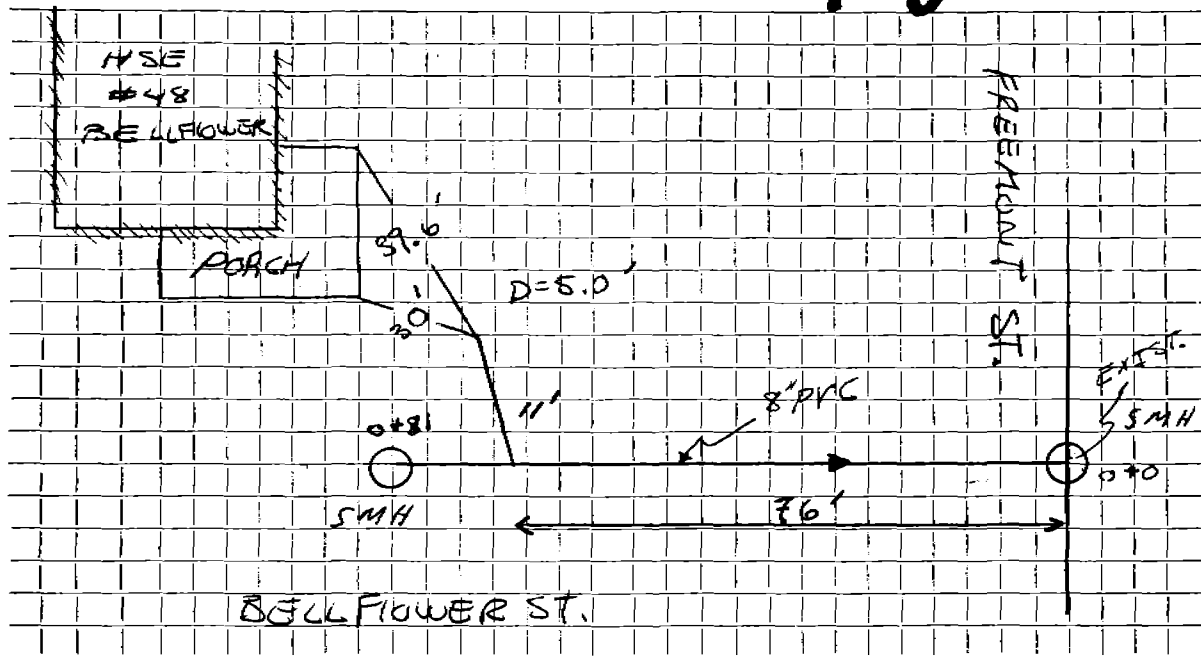

Connection made in Bellflower Street. Work completed

Remarks: