

Name Maxant

Service No. 50

Address 52 Bellflower Street

Lots 624 - 626 Sta. 6*87

Location

Kind of Pipe

Size

Size of Main

~~Repair~~ ~~Renewal~~ ~~New Service~~ Suburbanite #3946

Location FEB 19 1985


Date	Material	Amount	Total	Date	Amount
9/10/63	Labor 19.40			12-23-84 Deposit	132.98
9/11/63	" 52.74	72 14			
	10% O.H.	7 21	79.35		
	18' 6" Transite pipe @.82		14.76		
	1 6" Adapter		1.62		
	1 6" Service Saddle		5.25		
	4 hrs. Town Shovel @ 6.50		26.00		
	2 hrs. Trucking @3.00		6.00		
	BILL WHEN CONNECTED		132.98		
12/21/84	26' x 6" PVC				
	1 22 1/2° x 6" Elbow				
	1 45° x 6" Elbow				
	1 6" PVC x Tran. Adaptor				
	1 6" x 4" Donut				

DATE SEPT 1963

TOWN OF LEXINGTON — BOARD OF PUBLIC WORKS
SEWER DIVISION

Sketch of Service Here

52

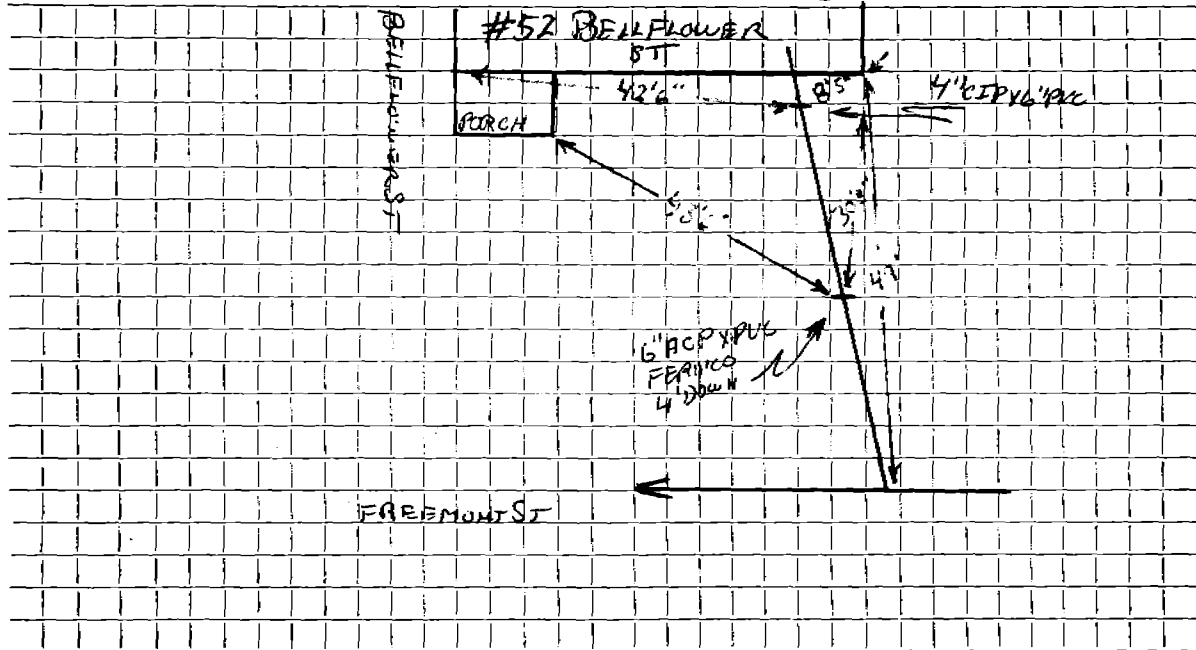

Connection made in FREEMONT ST Street.

Work completed DEC. 1984

Remarks: