

Name Lincoln Shedd

Service No. 45

Address 7 Bellflower St.

Location

Kind of Pipe

Size

Size of Main

~~Report Request~~ New Service

Location *Comm 7-5-60*


Date	Material	Amount	Total	Date	Amount
5-3-60	Labor	82.68		<i>4-21-60</i>	<i>Deposit</i>
	10% O.H.	8.27	90 95	<i>7-5-60</i>	<i>Refund</i>
	47' 6" Transite Pipe @ .78		36 66		
	1 22 $\frac{1}{2}$ ^o Transite Bend		6 21		
	2 11 $\frac{1}{4}$ ^o Transite Elbow @ 2.24		4 48		
	3 Hrs. Town Shovel @ 6.50		19 50		
	2 Hrs. Trucking @ 3.00		6 00		
	1 Hr. Trojan Loader @ 3.00		3 00		
			166 80		

DATE _____

TOWN OF LEXINGTON — BOARD OF PUBLIC WORKS
SEWER DIVISION

Sketch of Service Here

7

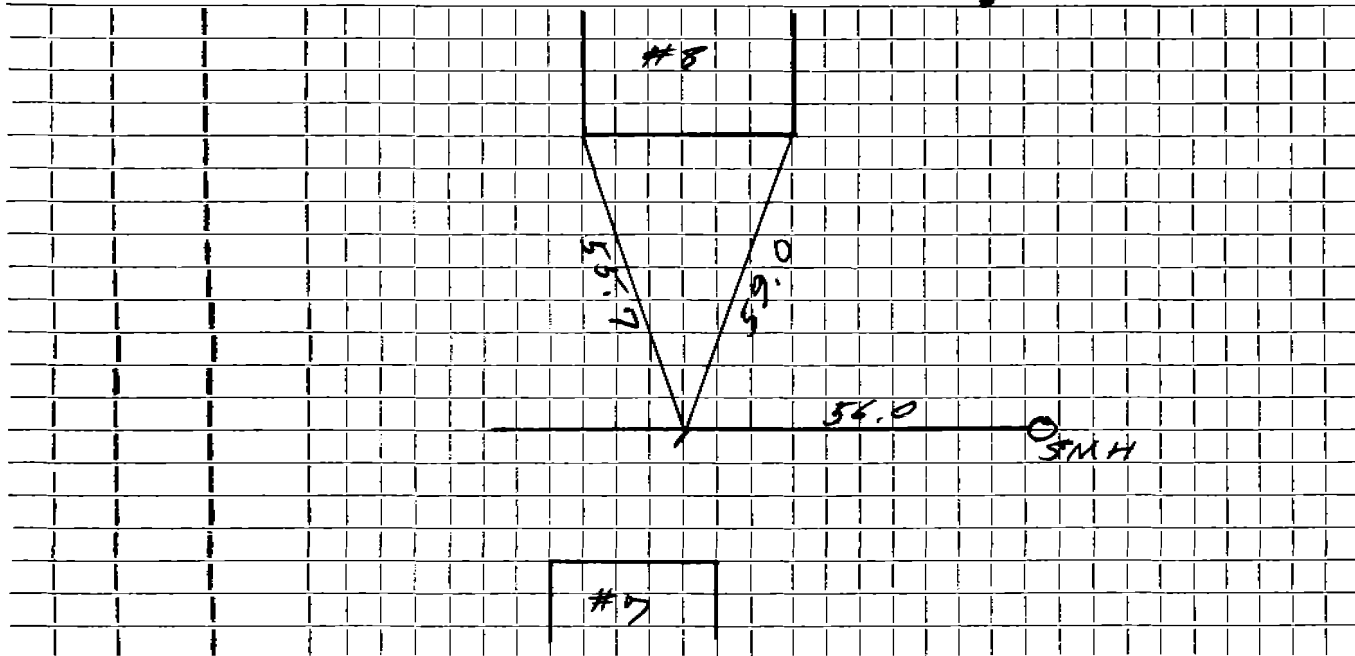

Connection made in Street. Work completed

Remarks:

.....

.....