

Name Francis Matthews

Service No. 149

Address 8 Bellflower Street

Location

Kind of Pipe

Size

Size of Main

~~Repair/Removal~~ New Service

Location *Comm 11-16-59*

Date	Material	Amount	Total	Date		Amount
9-11-59	Labor	95.50		8-26-59	Deposit	200.00
	10% O.H.	9.55	105.05	11-16-59	Retard	25.06
	53' 6" Transite pipe@.70		37.10			174.94
	1 8" Transite Elbow 90°		5.29			
	4 Hrs. Pipping Shovel@6.50		26.00			
	2 Hrs. Trucking@.75		1.50			
			174.94			


DATE _____

TOWN OF LEXINGTON — BOARD OF PUBLIC WORKS

SEWER DIVISION

Sketch of Service Here

8

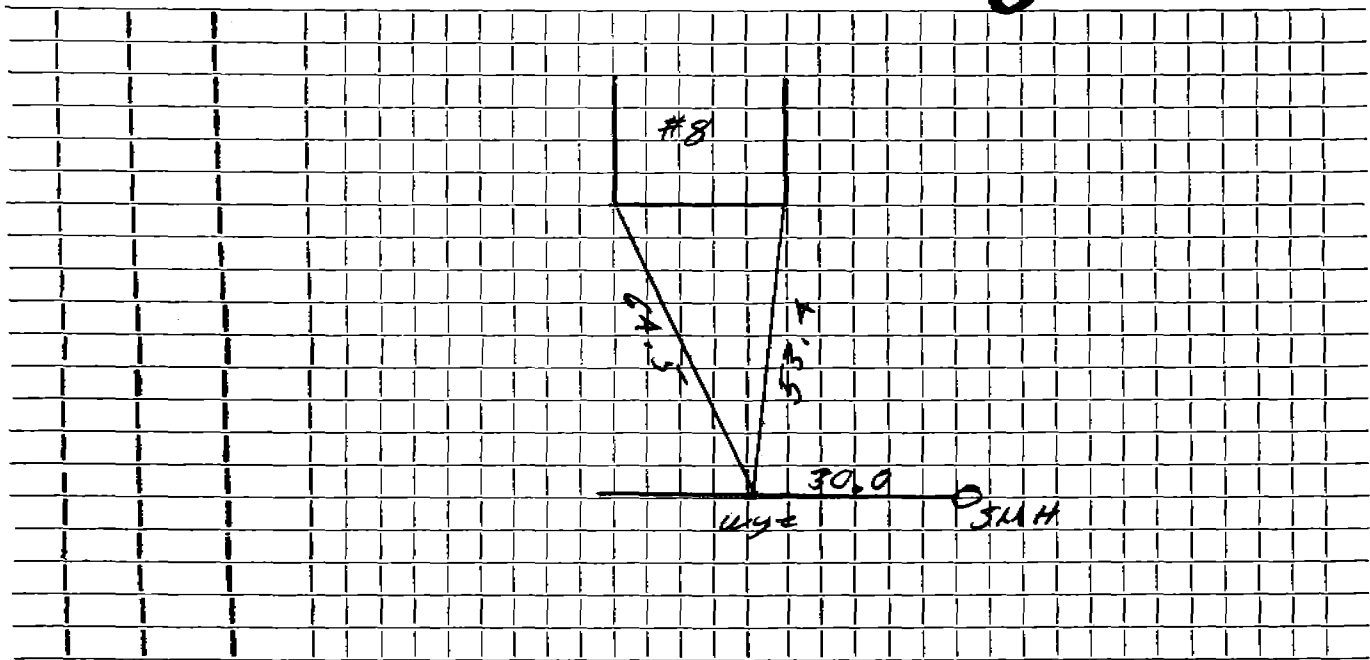

Connection made in Street. Work completed

Remarks:
.....
.....