

DATE _____

TOWN OF LEXINGTON — BOARD OF PUBLIC WORKS
SEWER DIVISION


10" A.C.

BENJAMIN RD Sketch of Service Here

CONCORD AVE
19' SMH

5' Chim. Down St

2d of 6" A.C.

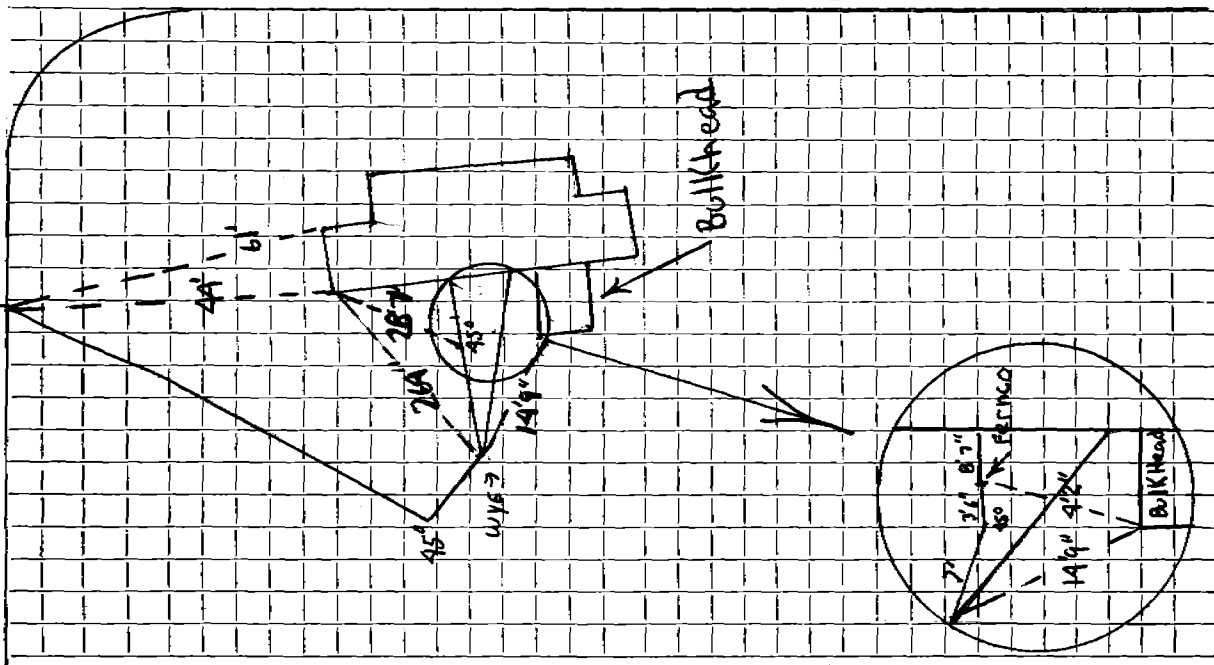

Connection made in Street. Work completed

Remarks:
.....