

Name 11 Benjamin Rd.

Service No.

Address

Location Lot L.C. 17

Kind of Pipe

Size

Size of Main

Repair—Renewal—New Service

Location

Date		Material	Amount		Total	Date	Amount
1971	20'	6" A.C. trasite					
		pipe @ 12.00	240	00			

DATE \_\_\_\_\_


# TOWN OF LEXINGTON — BOARD OF PUBLIC WORKS

## SEWER DIVISION

Sketch of Service Here

Lot L.C. 17

11

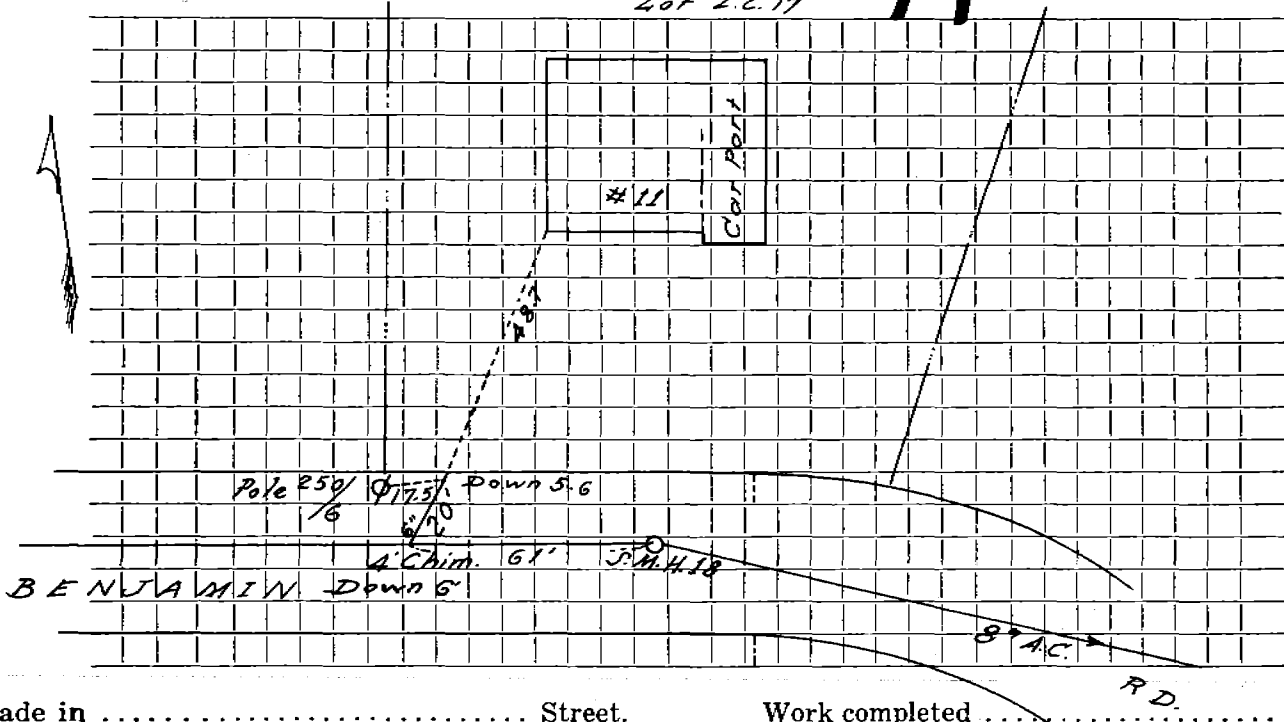

Connection made in ..... Street. Work completed .....

Remarks: .....

.....

.....