

Name Erwin Kapp
12 Benjamin Rd.

Service No. 16

Address

Location Lot L.C. 10

Kind of Pipe

Size

Size of Main

Repair—Renewal—New Service Trebino #2010

Location JUN 5 1972

Date		Material	Amount		Total	Date		Amount
1971	29'	6" A.C. transite pipe @ 12.00	348	00		3-4-72	Repair	348.00
4-24-72	35'	6" Transite pipe						
	10'	4" Cast Iron pipe						


F.B.N. 18501

DATE _____

TOWN OF LEXINGTON — BOARD OF PUBLIC WORKS

SEWER DIVISION

Sketch of Service Here **12**

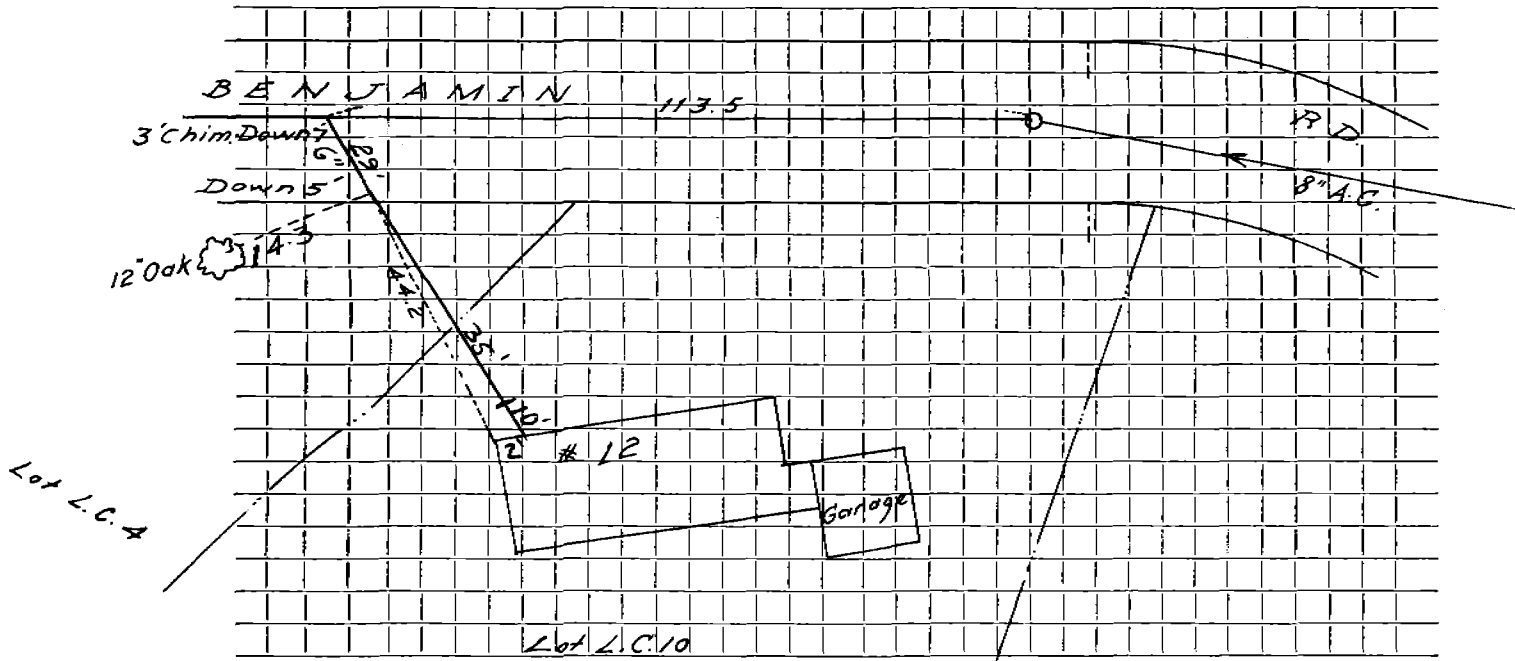

Connection made in Street. Work completed

Remarks:
.....
.....