

Name Oscar Jankelson

Service No. 86

Address 16 Benjamin Rd.

Location Lot L.C. 32

Kind of Pipe

Size

Size of Main

Repair—Renewal—New Service

Valeri Construction #2738

Location AUG 16 1976


Date		Material	Amount		Total	Date		Amount	
1971	17'	6" A.C. transite pipe @ 12.00	204	00		9-3-75	Deposit	204	00
9/8/75	91'	6" Transite Pipe							
	10'	4" Cast Iron Pipe							

DATE \_\_\_\_\_

# TOWN OF LEXINGTON — BOARD OF PUBLIC WORKS

## SEWER DIVISION

Sketch of Service Here **16**

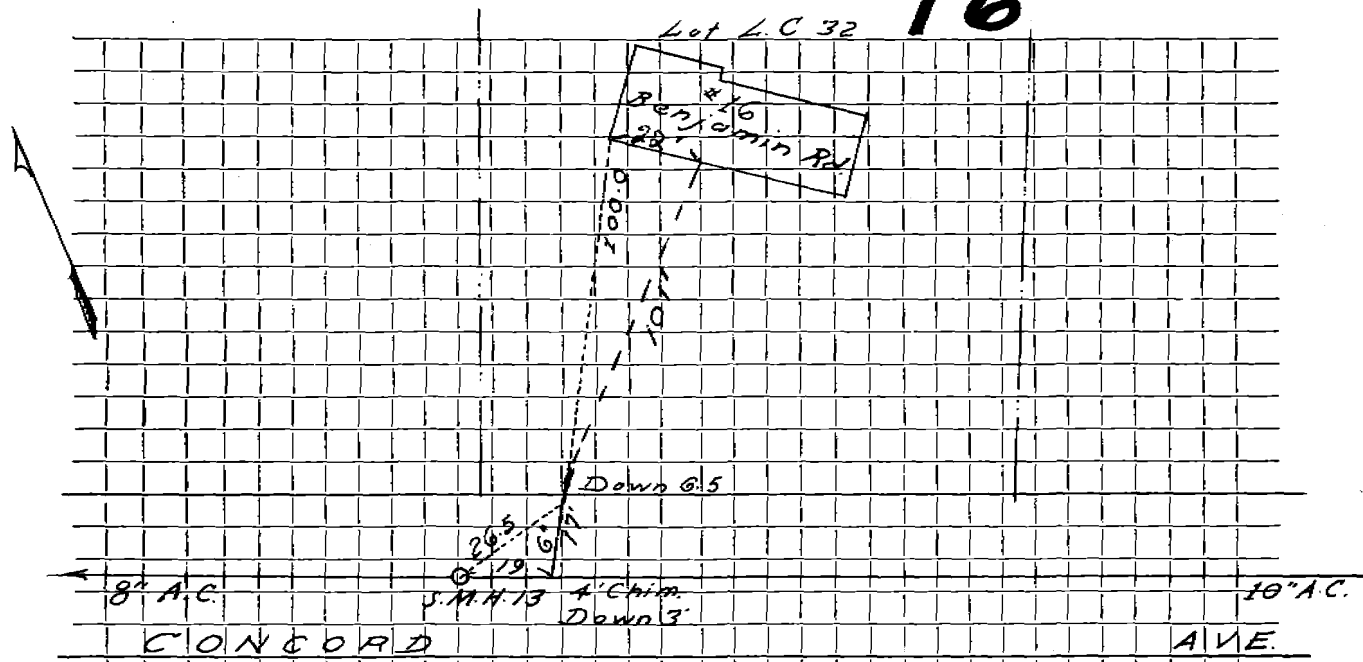

Connection made in CONCORD AVE. ~~16 Benjamin Rd.~~ Street. Work completed 9/8/75

Remarks: .....

.....

.....