

Name Tony Gentile

Service No.

Address 17 Benjamin RD

J. McLaughlin

Location

Kind of Pipe PVC

Size

Size of Main

Repair—Renewal—New Service


Location

Date	Material	Amount		Total		Date		Amount
12/9/04	7.4"	4" sch 40						
	40.0'	6" PVC						
	1	4x6 Ferroc						
	1	6" AC x PVC Ferroc						
	Exist AC.							

DATE _____

TOWN OF LEXINGTON — BOARD OF PUBLIC WORKS
SEWER DIVISION

Sketch of Service Here

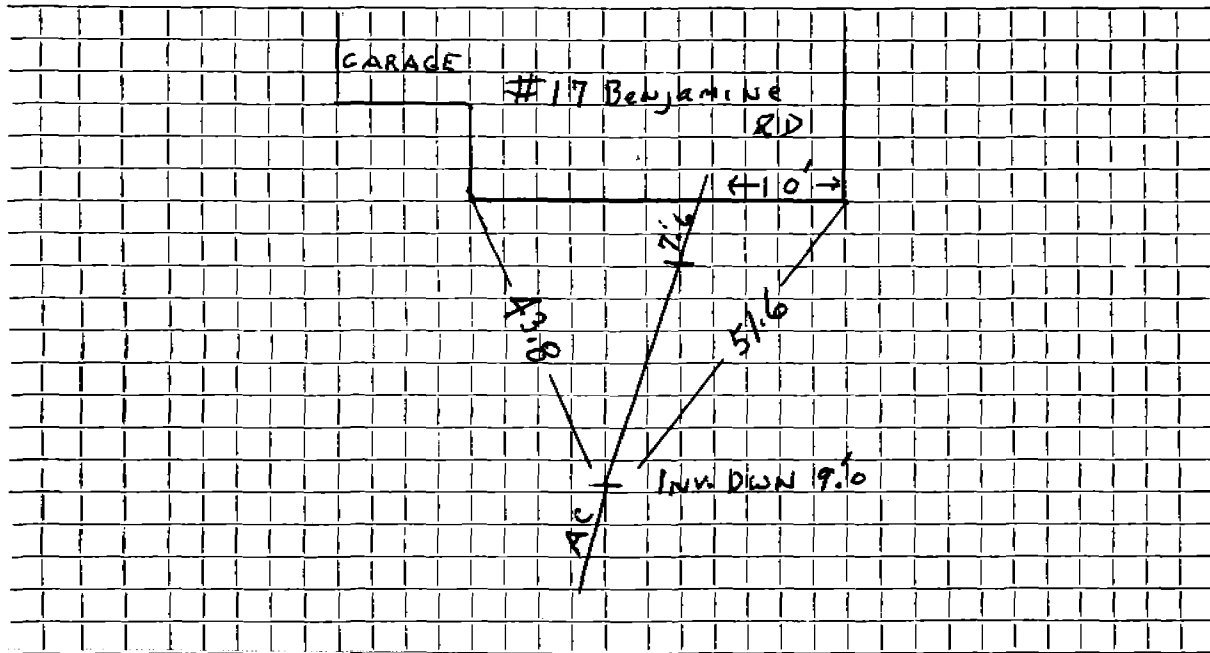

Connection made in Street. Work completed .. 12/9/04

Remarks:
.....
.....