

DATE _____


TOWN OF LEXINGTON — BOARD OF PUBLIC WORKS

SEWER DIVISION

Sketch of Service Here

Lot L.C. 31

18

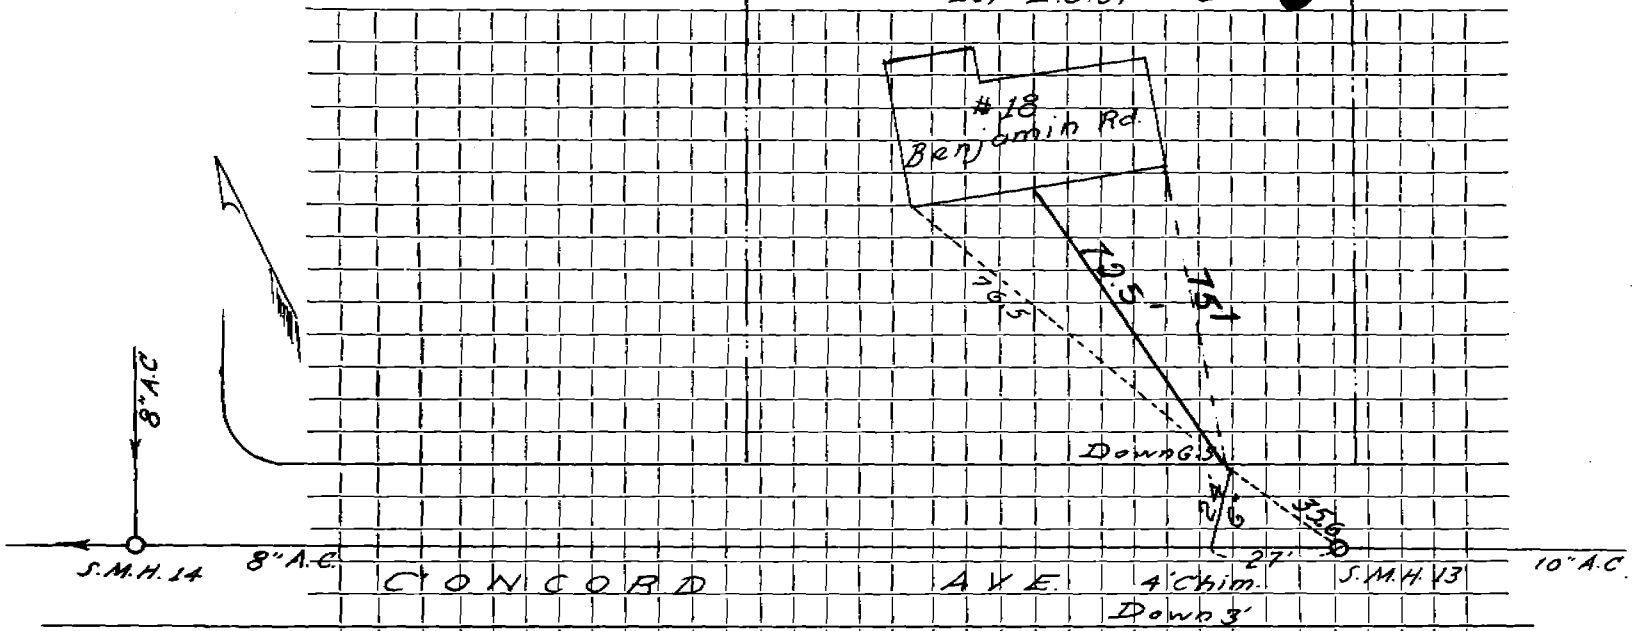

Connection made in CONCORD AVE - # Benjamin Rd. Street. Work completed 6/26/75

Remarks:

.....

.....