

Name M. Claire Herterick
19 Benjamin Rd.

Service No. 75

Address

Location Lot L.C. 14

Kind of Pipe

Size

Size of Main

~~Repair - Renewal~~ New Service Dave Eagle #3449

Location DEC 3 1979

Date	Material	Amount	Total	Date	Amount
------	----------	--------	-------	------	--------

1971 15'	6" A.C. transite pipe @ 12.00	180 00		11-23-79	Deposit 180 00
----------	-------------------------------	--------	--	----------	----------------

11-29-79 70'	6" Transite pipe				
--------------	------------------	--	--	--	--


10'	4" Cast Iron pipe				
-----	-------------------	--	--	--	--

DATE _____

TOWN OF LEXINGTON — BOARD OF PUBLIC WORKS

SEWER DIVISION

Sketch of Service Here **19**
Lot L.C. 14

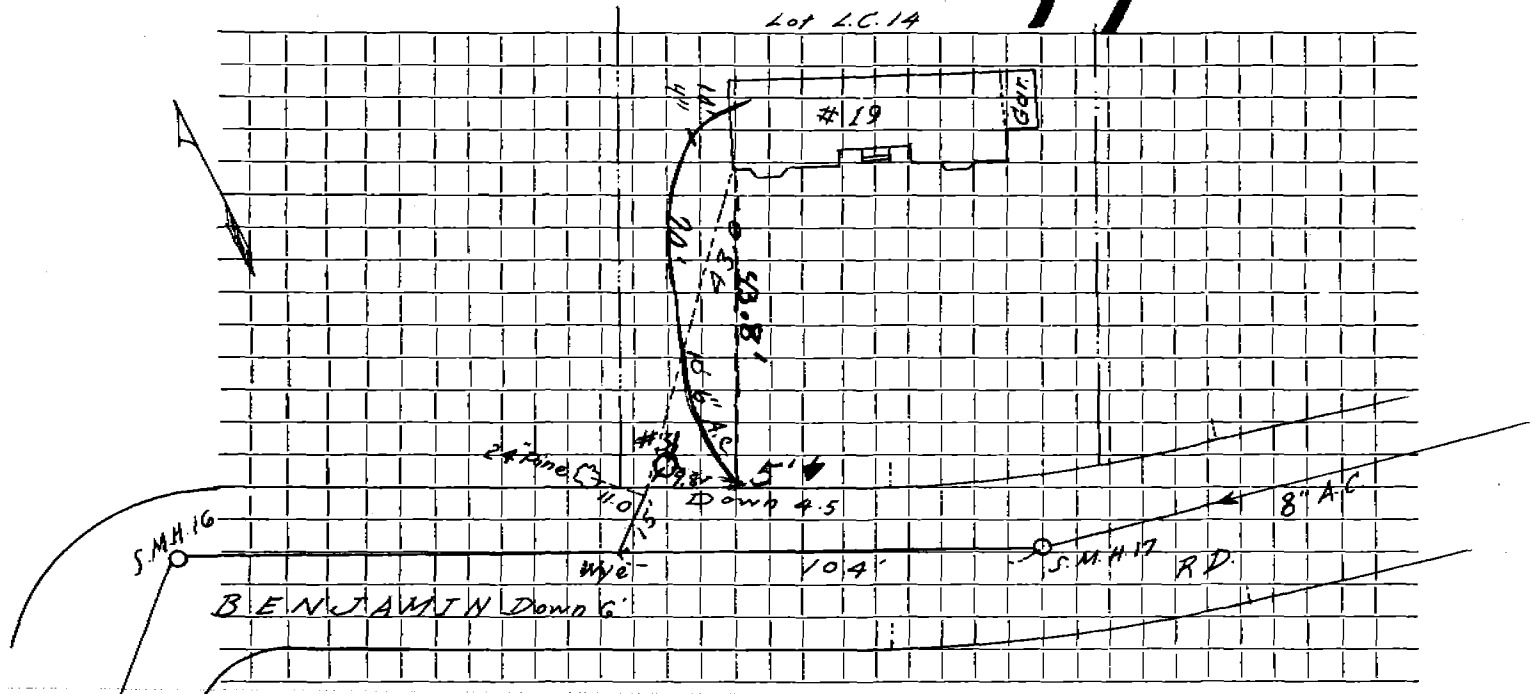

Connection made in Street. Work completed

Remarks:
.....
.....