

Name ~~2 Benjamin Rd.~~ Trinity Covenant Church

Service No.

Address 2 Benjamin Rd.

Location Lot L.<sup>U</sup>. 7

Kind of Pipe

Size

Size of Main

Repair—Renewal—New Service

Location

Date		Material	Amount		Total	Date		Material	Amount	
1971	20'	6" A.U. transite pipe @ 12.00	240	00		Sept. 16	1998	104' 6" PVC		
								2 - 22° Bends		
								1 - 45° BEND		
								2 - 6x6x6 WYE clean outs		
								1 - 6x4 FERNCO		
								1 - 6x6 FERNCO		


DATE \_\_\_\_\_

# TOWN OF LEXINGTON — BOARD OF PUBLIC WORKS

## SEWER DIVISION

2

Sketch of Service Here

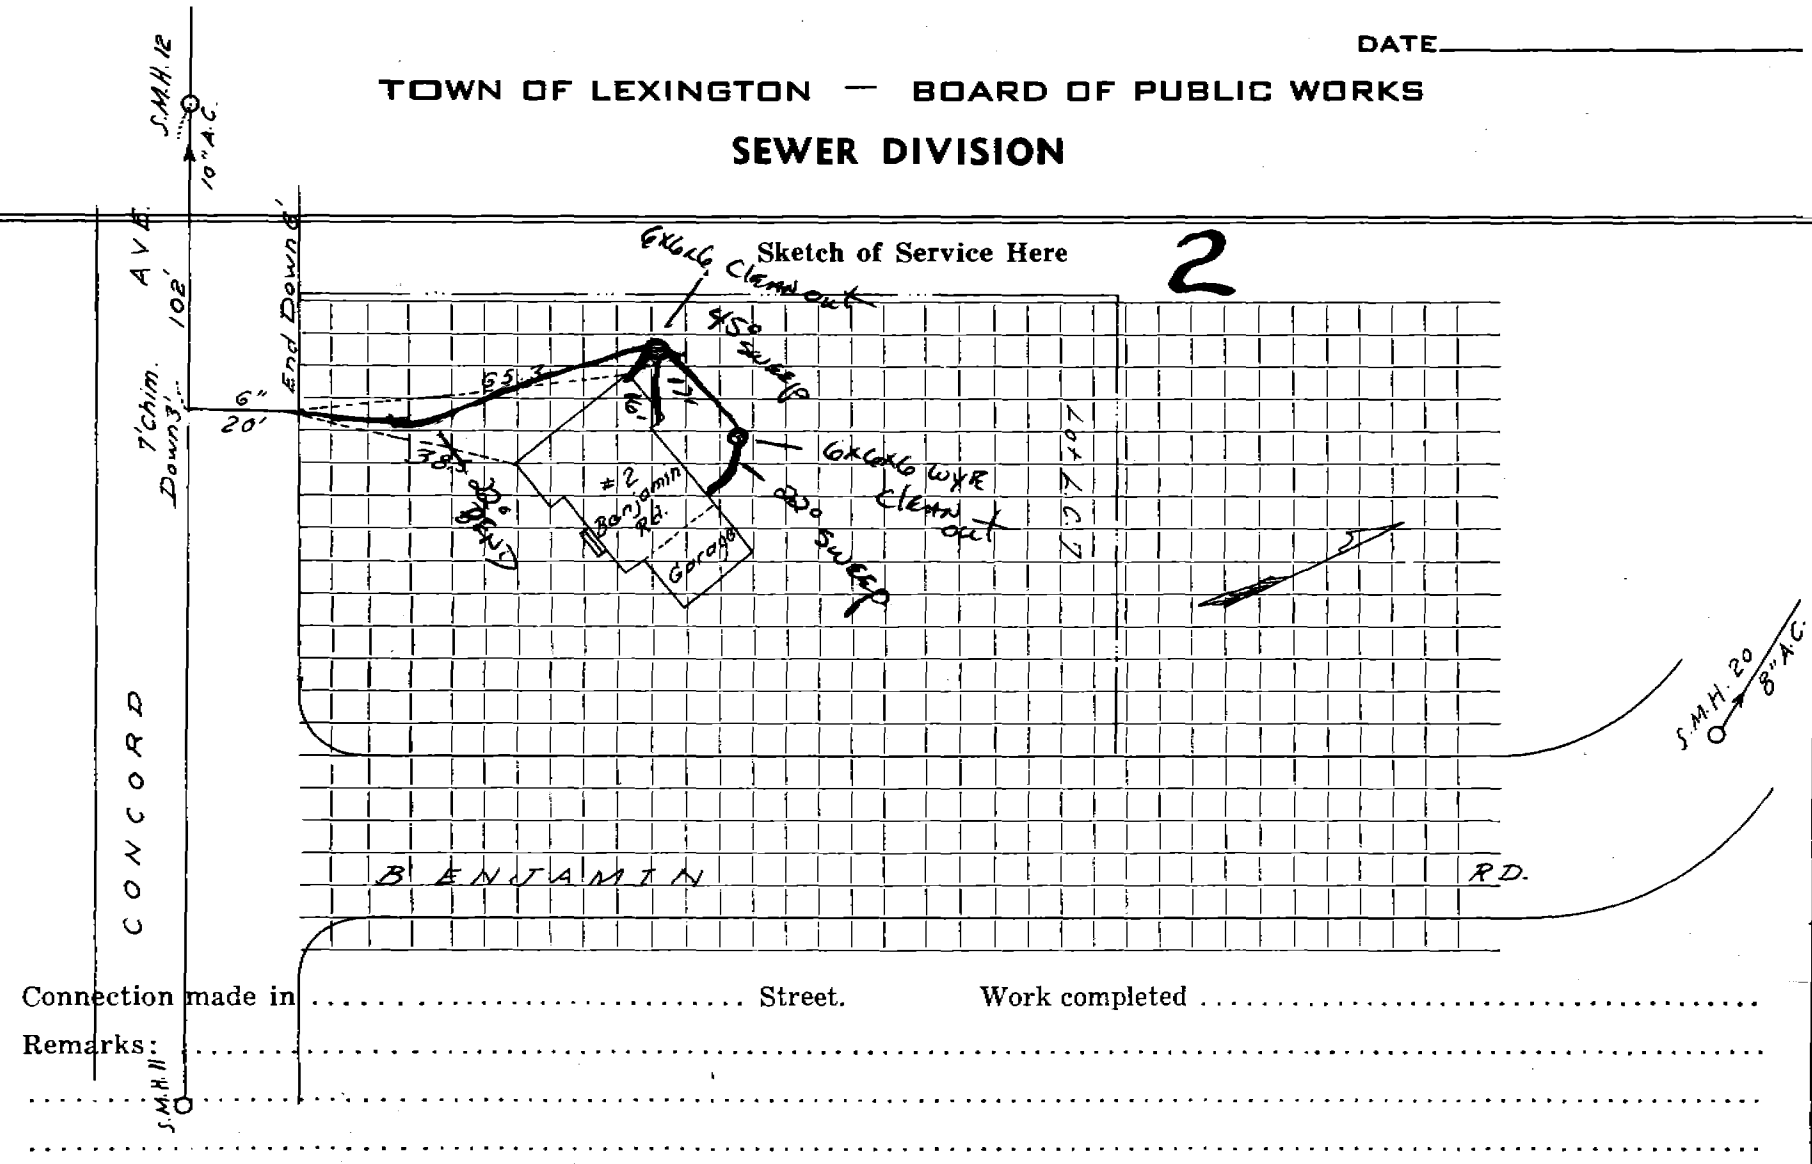

Connection made in ..... Street. Work completed .....

Remarks: .....