

Name Robert Hunter

Service No. 38

Address 20 Benjamin Rd.

Location Lot L.C. 30

AUG 6 1979

Kind of Pipe

Size

Size of Main

~~Repair/Replace~~ New Service Valeri #3236

Location

Date	Material	Amount	Total	Date	Amount
------	----------	--------	-------	------	--------

1971 19'

6" A.C. transite
pipe @ 12.00

228 00

6-5-79

Deposit

228 00

June 1979 47'


Transite Pipe

DATE _____

TOWN OF LEXINGTON — BOARD OF PUBLIC WORKS
SEWER DIVISION

Sketch of Service Here

20

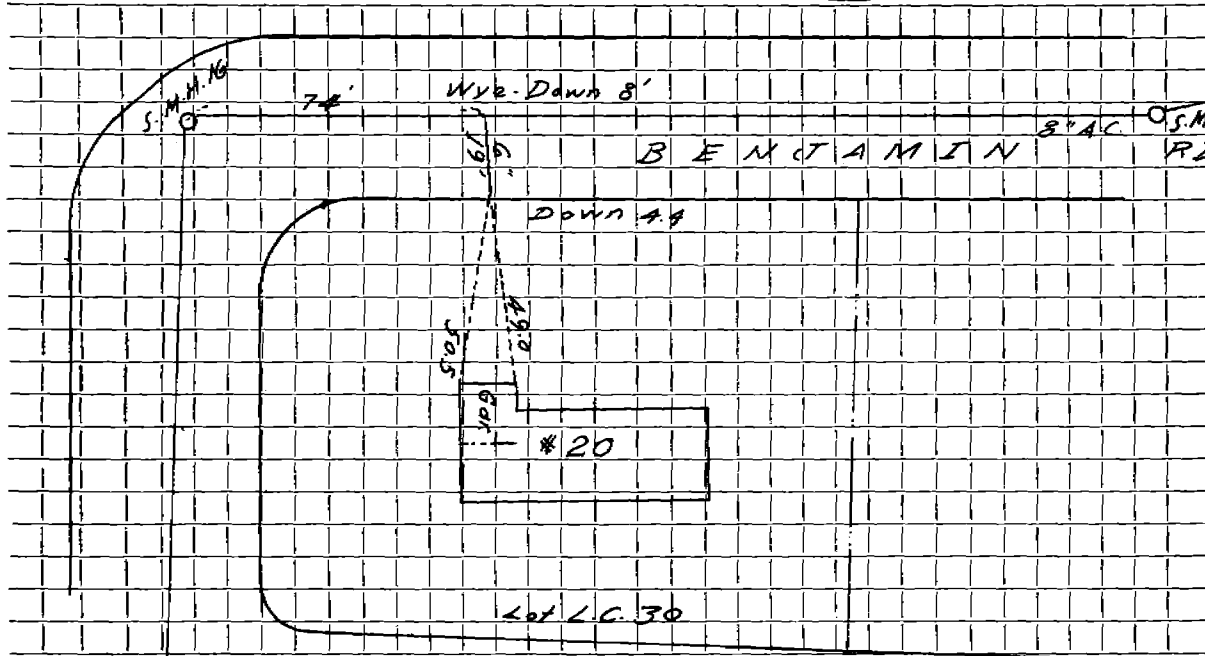

Connection made in Street. Work completed

Remarks:
.....
.....