

Name

Service No.

Address 21 Benjamin Rd.

Location Lot L.C. 13

Kind of Pipe

Size

Size of Main

Repair—Renewal—New Service

Location

Date

Material

Amount

Total

Date

Amount

1971 20'

6" A.C transite
pipe @ 12.00


240 00

DATE _____

TOWN OF LEXINGTON — BOARD OF PUBLIC WORKS
SEWER DIVISION

Sketch of Service Here

21

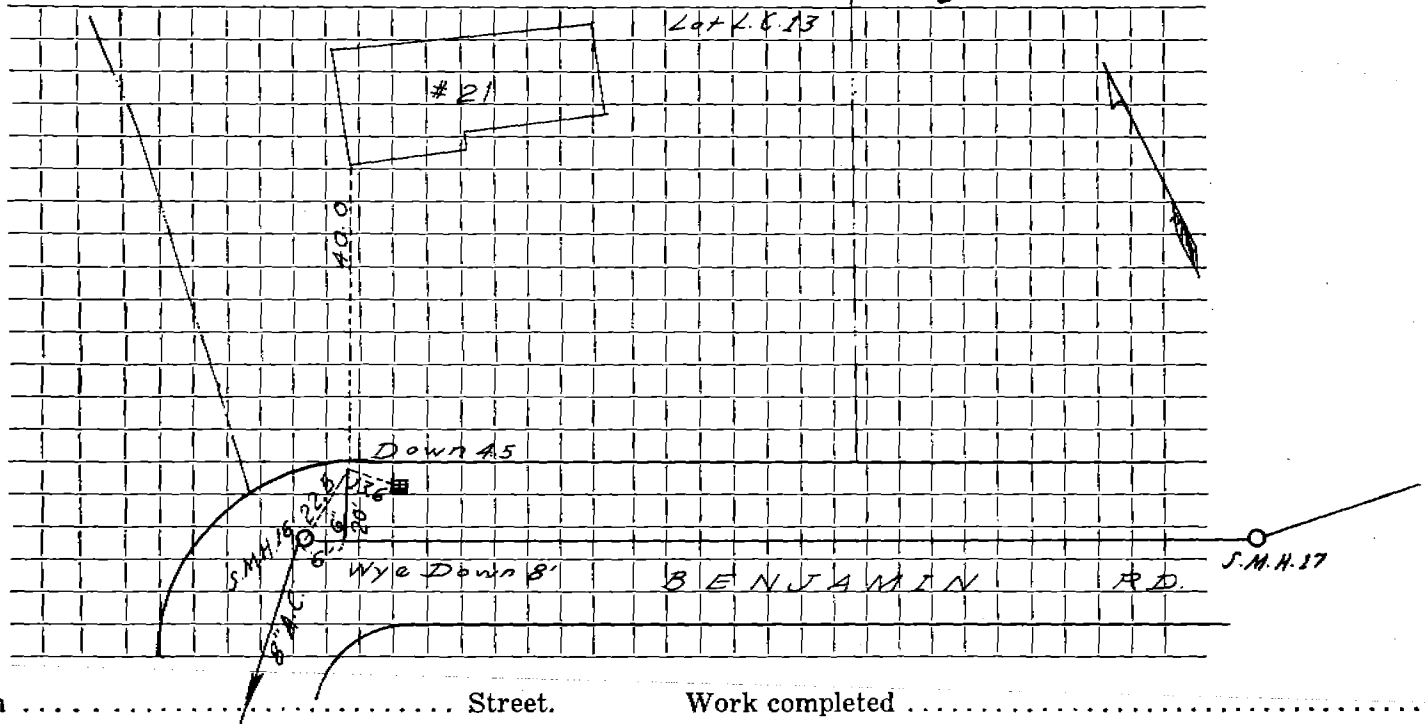

Connection made in Street. Work completed

Remarks:
.....
.....