


DATE _____

TOWN OF LEXINGTON — BOARD OF PUBLIC WORKS
SEWER DIVISION

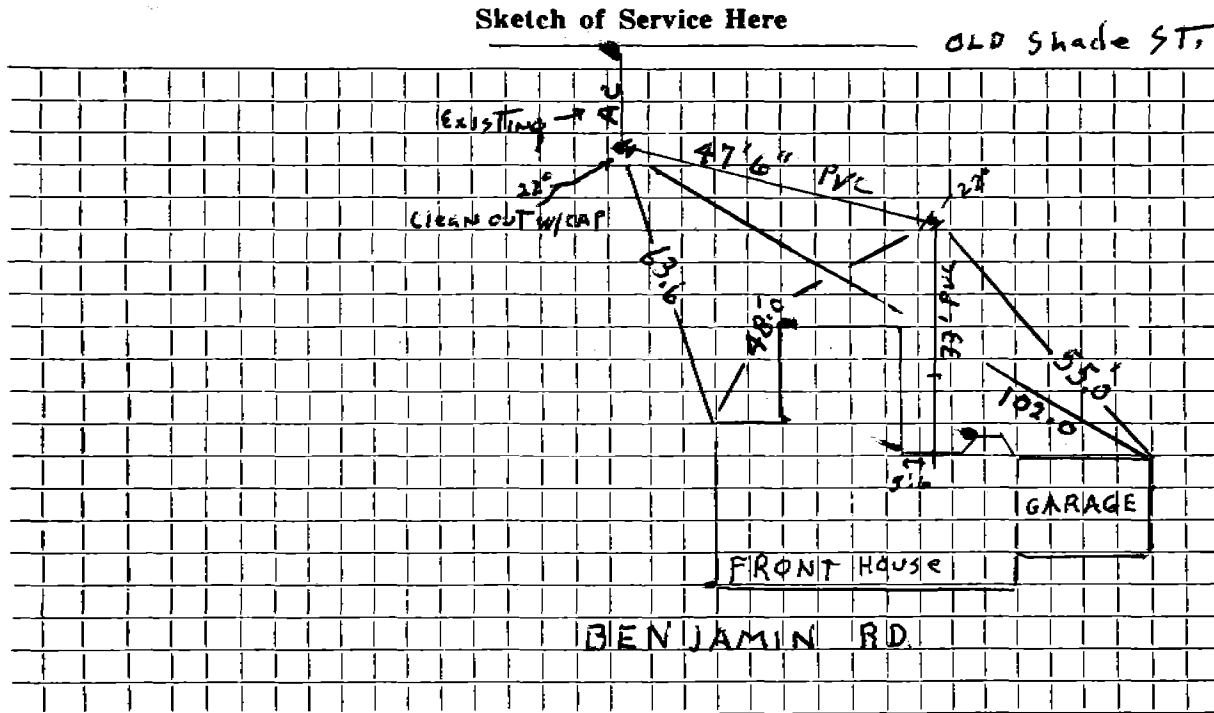

Connection made in OLD Shade ST. Street.

Work completed 7/14/04 J-McLaughlin

Remarks: 2002-Demos. Lowerd. Chim. 50 Service would go Under New W/MAN. (see old card)

Name Roger Roberge
3 Benjamin Rd.

Service No. 40

Address

Location

Lot L.C. 21

Kind of Pipe

Size

Size of Main

Repair—Renewal—New Service

Valeri #2037

Location JUN 5 1972

Date		Material	Amount		Total	Date	Amount
1971	30'	6" A.C. transite pipe @ 12.00	360	00		4-14-72 Deposit	360 00
4-24-72	116'	6" Transite pipe					
	10'	4" Cast Iron pipe					
Sep 02		DEMI Lower D CHIM					
	7.5	6" PVC					
	1	90° EL					
	1	ACX PVC Ferroc					

DATE _____


TOWN OF LEXINGTON — BOARD OF PUBLIC WORKS

SEWER DIVISION

8" A.C.

Sketch of Service Here

3

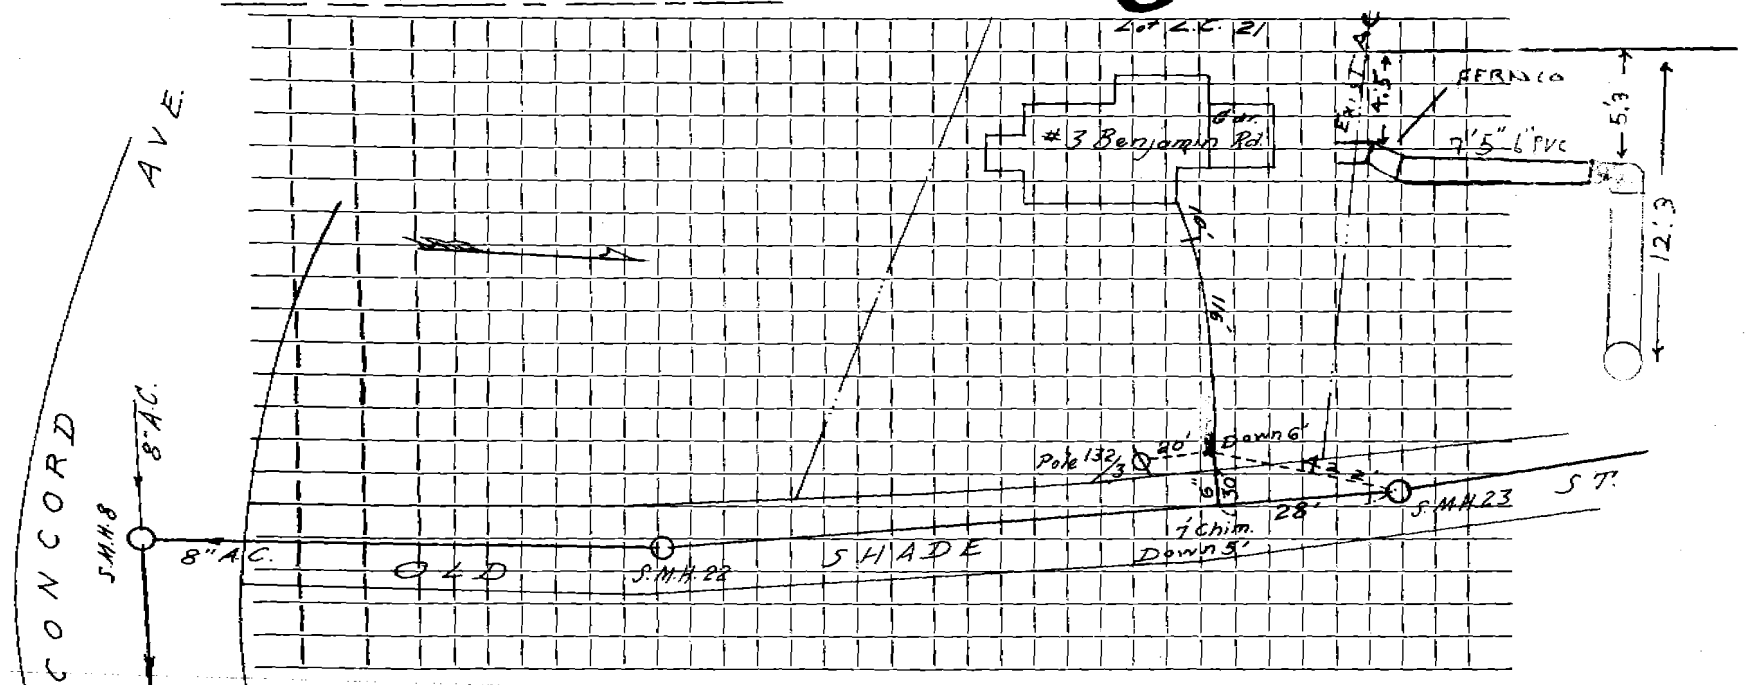

Connection made in _____ Street. Work completed 2002

Remarks: Lower d. Chime. To Go Under NEW WATER MAIN Dem