


DATE 4/5/96

TOWN OF LEXINGTON — BOARD OF PUBLIC WORKS
SEWER DIVISION

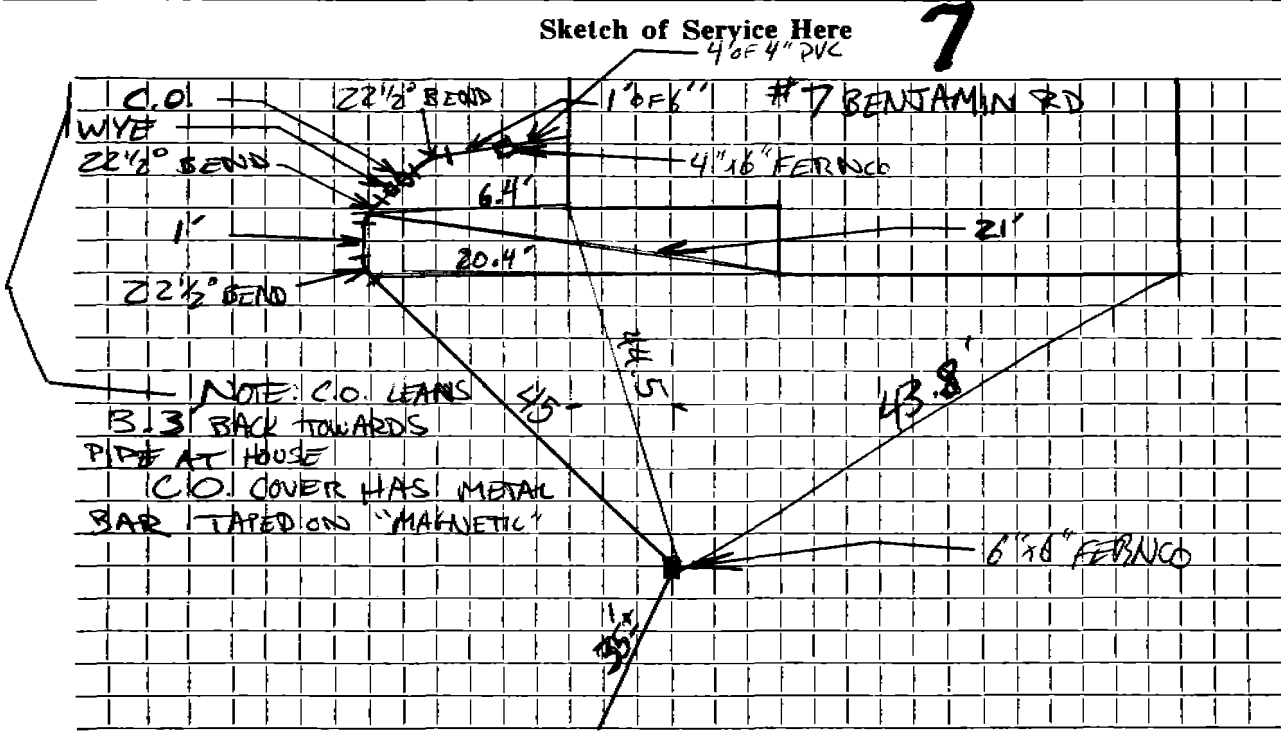


Connection made in Street. Work completed

Remarks:
.....
.....

DATE _____

TOWN OF LEXINGTON — BOARD OF PUBLIC WORKS SEWER DIVISION

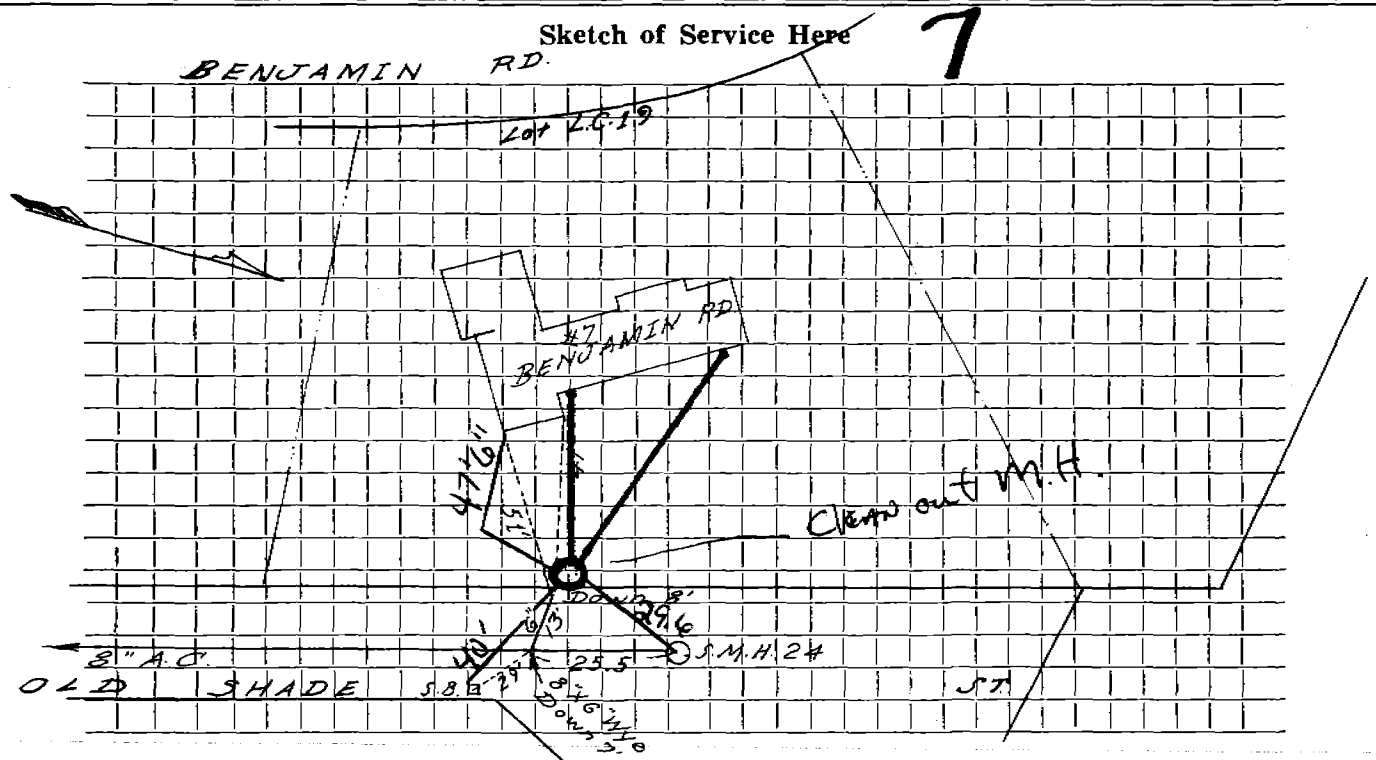

Connection made in Street.

Work completed

Remarks: ~~Stoppage about 56'~~
~~Town will Respond~~

base has two service pipes
going into clear-out M.H.