

Name Joseph Tavilla

Service No. 132

Address 8 Benjamin Road

Location Lot L.C.9

Kind of Pipe

Size

Size of Main


Repair—Renewal—New Service Trebino #2011

Location JUN 5 1972

Date	Material	Amount	Total	Date	Amount
1971 / 19	19' 6" Transite pipe @	12.00	228.00	12-28-71	Deposit
4-12-72	41' 6" Transite pipe				528.00
	5' 4" Cast Iron pipe				

DATE _____

TOWN OF LEXINGTON — BOARD OF PUBLIC WORKS
SEWER DIVISION

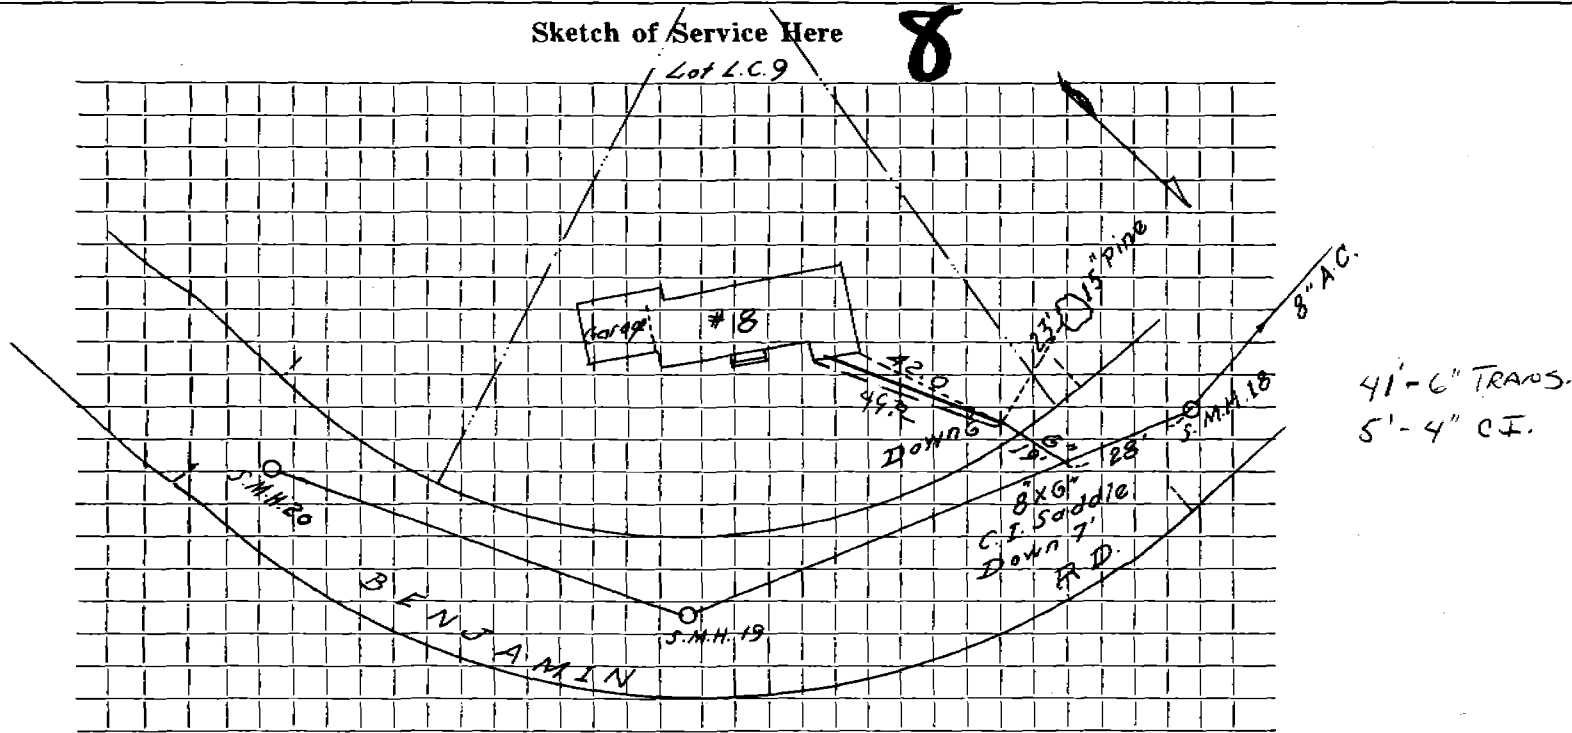

Connection made in Street. Work completed

Remarks:
.....
.....