

Name John H. Haughey

Service No. 13

Address 9 Benjamin Road

JUN 18 1973

Location Lot L.C 18

Kind of Pipe

Size

Size of Main

~~REPAIR/RENEW~~—New Service

Valeri Construction #2305

Location

Date		Material	Amount		Total	Date	Amount	
1971	19'	6" A.C. transite				3-16-73	Deposit	228 00
		pipe @ 12.00	228	00				
5-7-73	108'	6" transite						


DATE _____

TOWN OF LEXINGTON — BOARD OF PUBLIC WORKS

SEWER DIVISION

Sketch of Service Here

9

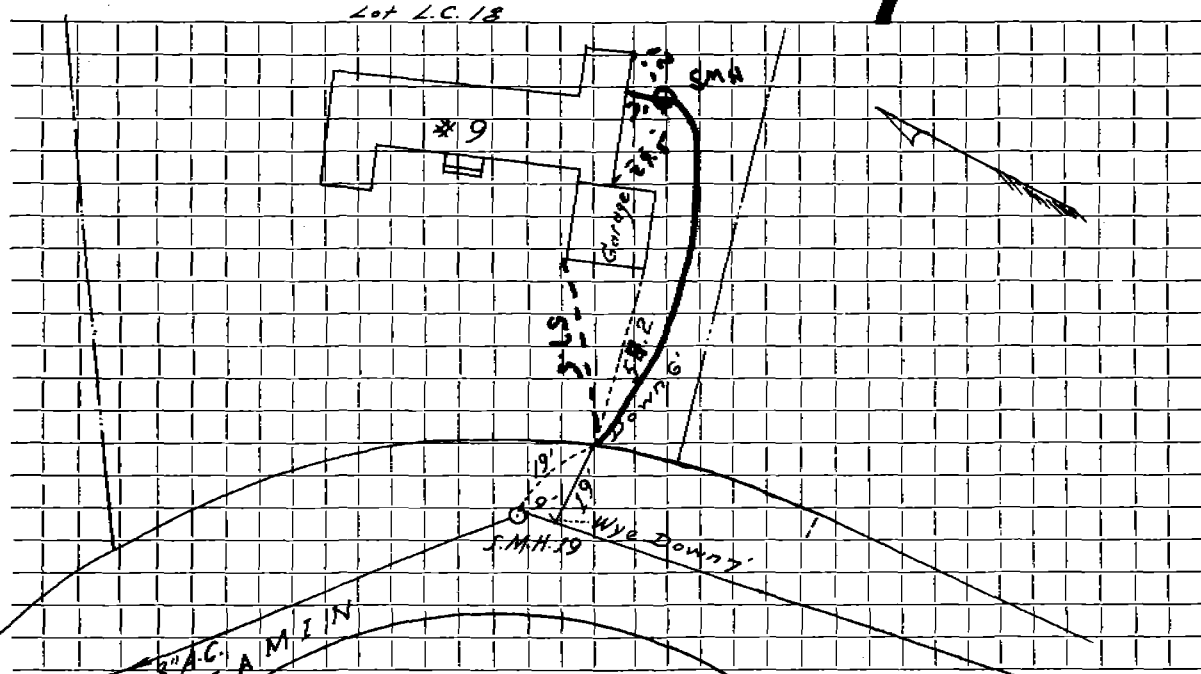

Connection made in S.M.H. 18 Street. Work completed R.D.

Remarks:

.....

.....