

Name Gladys Pawlowski

Service No. 1062

Address 15 Bennett Avenue
 Lexington, Mass.

Location 15 Bennett Avenue

Kind of Pipe

Size

Size of Main

~~Repair/Renewal~~ - New Service

Location

Date	Material	Amount	Total	Date	Amount
Apr. 16, '47	Labor	49 08	49 08	April 9 '47	90 00
	10% Overhead		4 91	May 22 '47	22 13
	36' - 6" Sewer Pipe @.24		8 64		67 57
	1 - 6" 1/8 Bend		1 28		
	Joint Compound		2 16		
	Trucking 2 hrs. @.75		1 50		
			67 57		
	Labor				

TOWN OF LEXINGTON—DEPT. OF PUBLIC WORKS

SEWER DIVISION

DATE

NO.

The undersigned applies for the construction of a particular sewer connecting No.
Street and hereby agrees to comply with the Rules and Regulations governing the construction and use of Particular
Sewers, as now or at any future time established by the Board of Selectmen.


Am't of estimate \$.....

Am't Paid \$.....

..... Owner

Sketch of Service Here

15

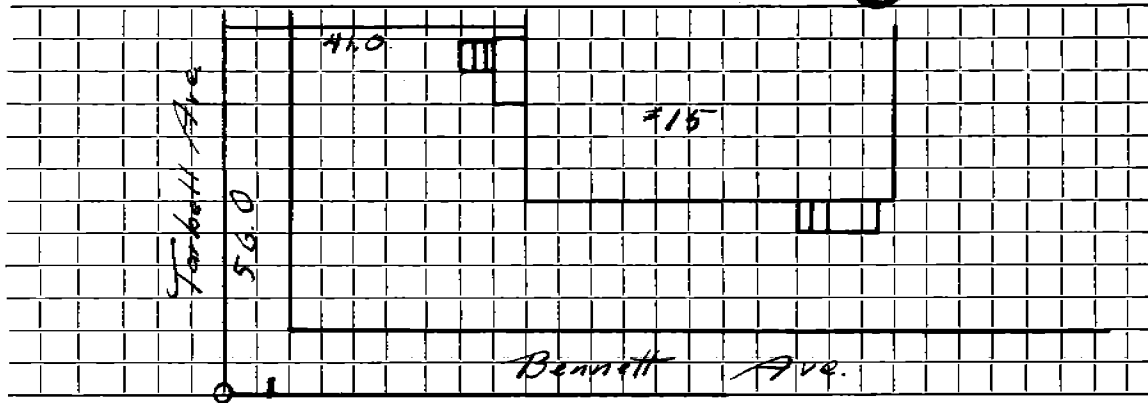

Connection made in Street.

Work completed 19..

Remarks: