


DATE _____

TOWN OF LEXINGTON — BOARD OF PUBLIC WORKS

SEWER DIVISION

Sketch of Service Here /

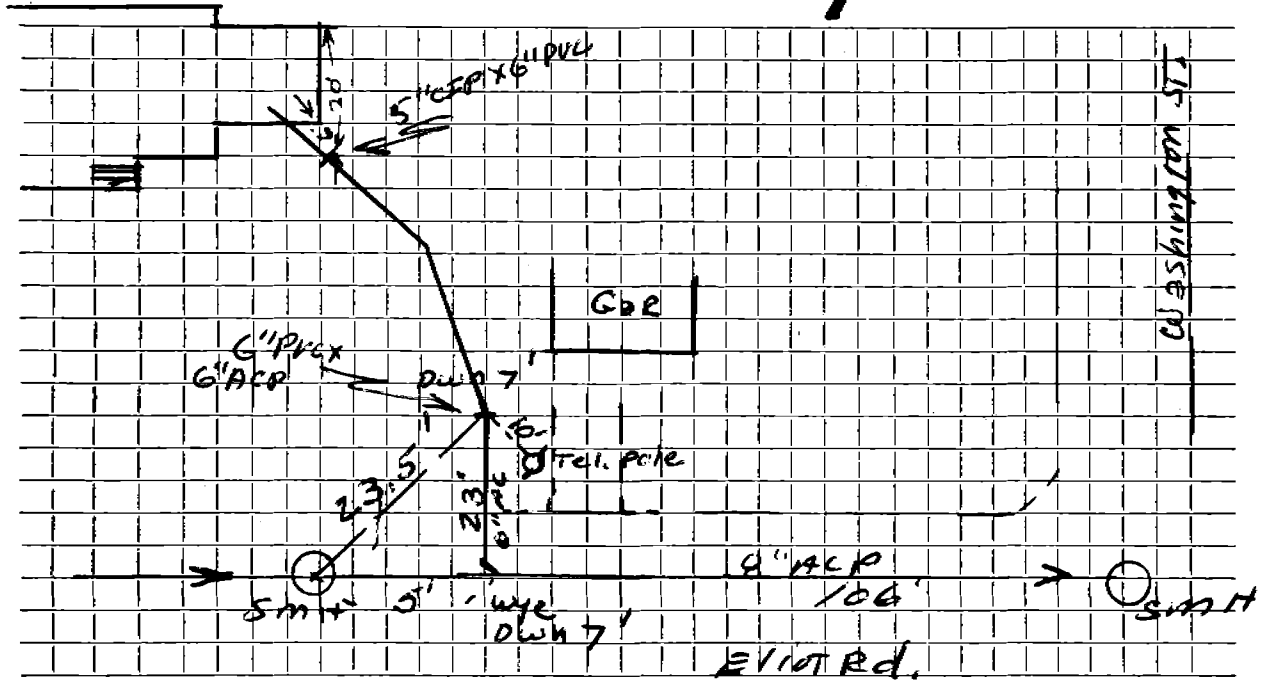

Connection made in ... ELIOT R.D. ... Street. Work completed MAY 1986

Remarks:
.....
.....