




DATE \_\_\_\_\_

TOWN OF LEXINGTON — BOARD OF PUBLIC WORKS  
SEWER DIVISION

Sketch of Service Here

11

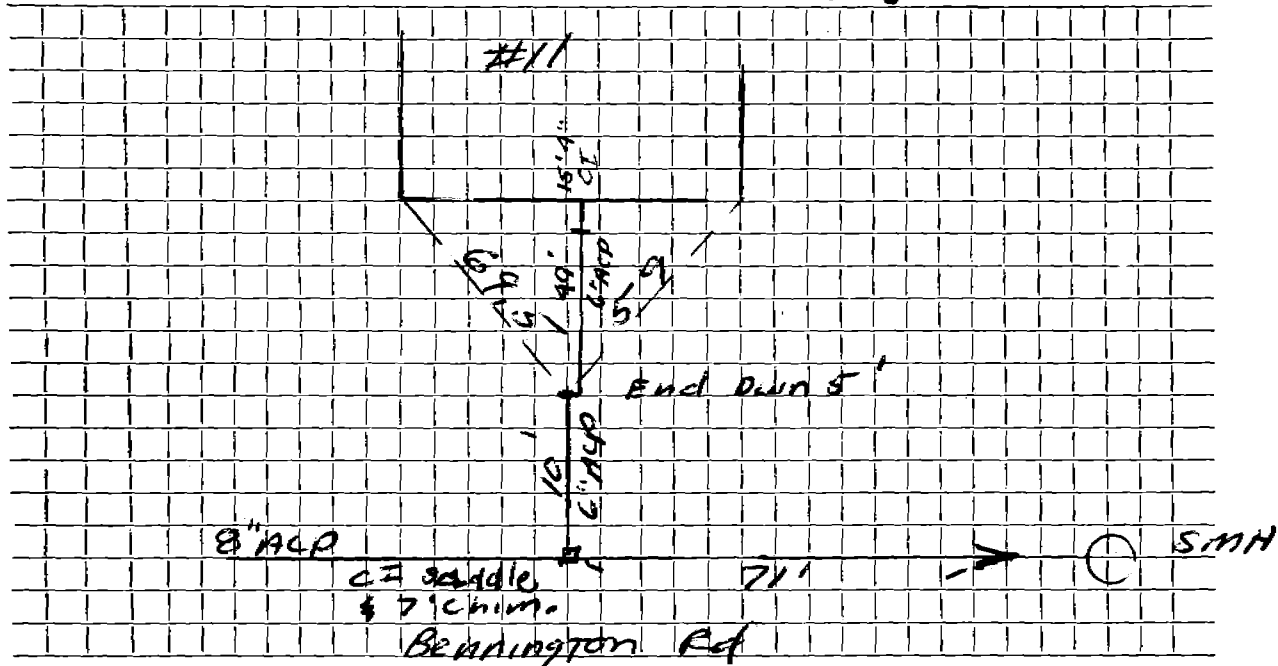

Connection made in .. Bennington Rd. Street. Work completed .....

Remarks: .....