


DATE _____

TOWN OF LEXINGTON — BOARD OF PUBLIC WORKS
SEWER DIVISION

Sketch of Service Here

11A

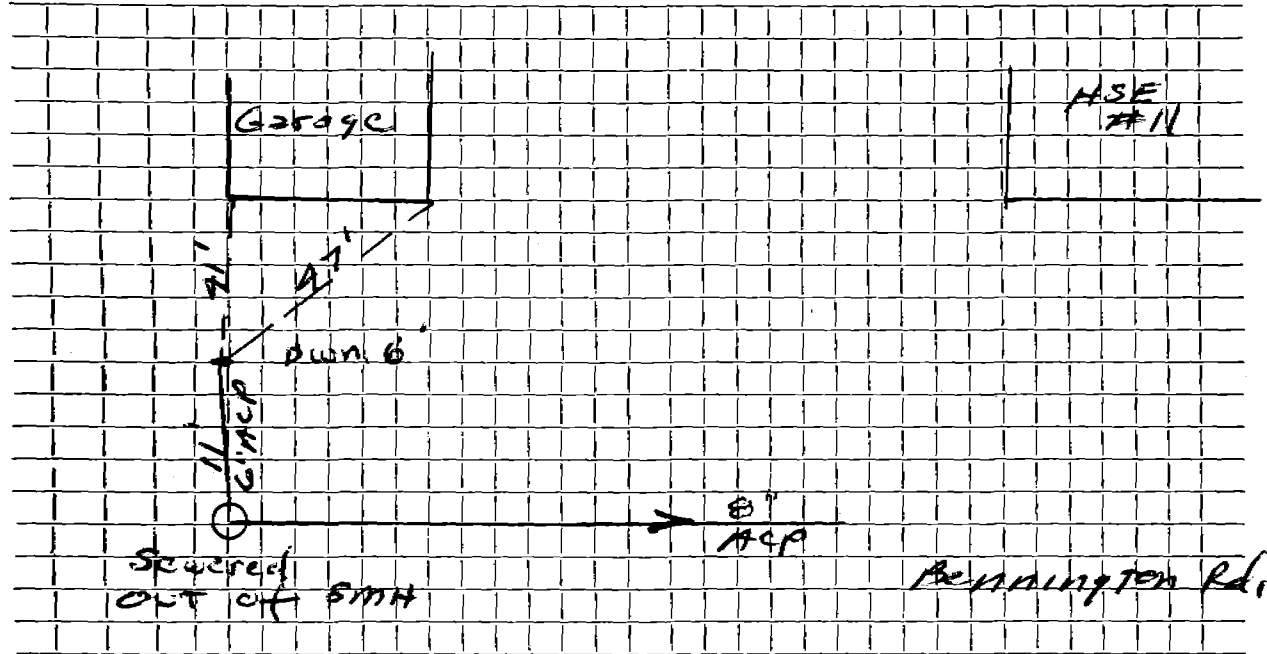

Connection made in .. Bennington Rd. .. Street.

Work completed

Remarks:

.....

.....