

Name Ken Nill

Service No. 64

Address #16 Bennington Rd.

Location

Kind of Pipe

Size

Size of Main

~~Required Current~~ New Service Valeri #3348

Location NOV 13 1978

Date	Material	Amount	Total	Date	Amount
8/9/78	28'-6" ACP @	\$16.53	\$462.84	10-11-78	Deposit
10/11/78	45' 6" Transite Pipe				
	15' 4" Cast Iron Pipe				
3-23-99	New house - New service			5/16/85	22' 6" PVC
	8' 4" PVC				1 Trans to PVC Adapter
	57' 6" PVC				1 6" 22 1/2 PVC Elbow MX Female
	1- 4x6 PVC to PVC Franco				1 6" Fernco Coupling PVC to Trans
	6" PVC to PVC coupling				1 Curb Box & Rod
					Patch - 27'x9'
				5-6-85	Blocked 77' Out


DATE _____

TOWN OF LEXINGTON — BOARD OF PUBLIC WORKS

SEWER DIVISION

Sketch of Service Here

16

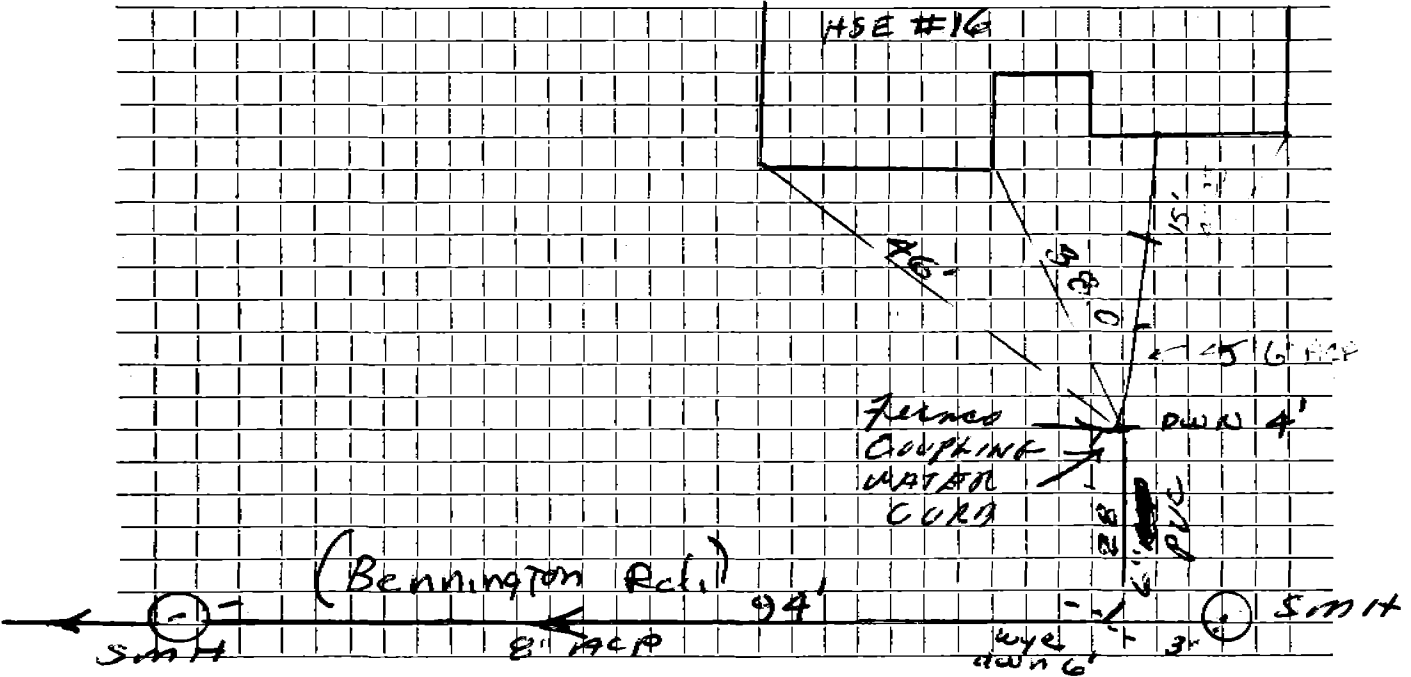

Connection made in Bennington Rd. Street. Work completed

Remarks: 3.23.99 New house built new service installed same ties