

Name Arnold S. Relmar

Service No. 246

Address 4 Bennington Road

Location

Kind of Pipe

Size

Size of Main

~~Repair~~ ~~Renewal~~ - New Service W.O. #1481



Location

OCT 3 1966

Date	Material	Amount	Total	Date		Amount
12-28-65	Labor	123 50		11-23-65	Repair	250
	10% O.H.	12 35	135 85	10-3-66	Deposit	49
	38' 6" Transite pipe @ .79		30 02		NON-CHARGE	200
	2 Hrs. Trucking @ 3.00		6 00	12-28-65	Labor 26.78	
	2½ Hrs. Shovel @ 6.50		16 25	12-29-65	106.42	
	1 Hr. Loader		4 00	3-8-66	36.75	169
	1½ Ton Hot Top @ 5.50		8 25		41' 8" C.I. Pipe @ 2.79	114
			200 37		1 Frame & cover	36
					4 Bag s cement @ 1.55	6
8/6/98	M.H.				1 4' Manhole	75
					5 Ton Bank grave 1 @ 1.10	5
					3 Hrs. Trucking @ 3.00	9
					2½ Hrs. Shovel @ 6.50	16
					1 Hr. Loader	4
					2 Ton Hot top @ 5.50	11
					1 Hr. Compressor	5
						452

DATE \_\_\_\_\_

# TOWN OF LEXINGTON — BOARD OF PUBLIC WORKS SEWER DIVISION

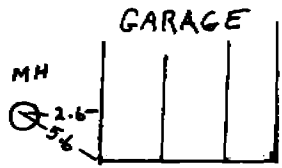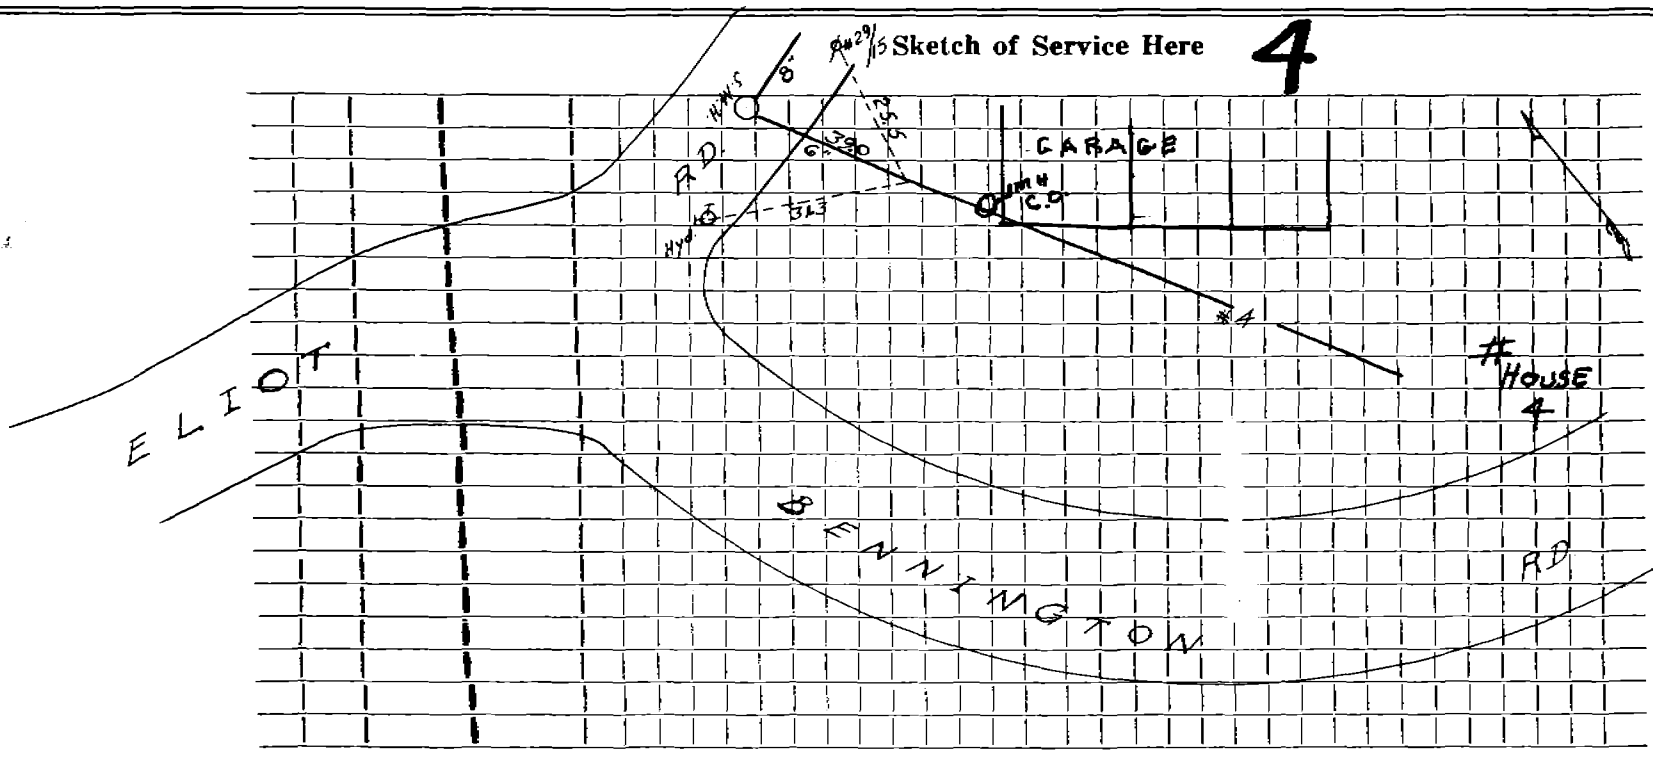

Work made in ..... Street. Work completed .....

Notes: 8/6/98 M.H. 13 WIT. OVER EXIST. SERVICE. WITH SERVICE FOR GARAGE FOR FUTURE.....

.....  
.....