

Name

Service No.

Address

Vacant Lot Bennington Rd, (Next to Hsc #7)

Location

Kind of Pipe

Size

Size of Main

Repair—Renewal—New Service

Location


Date	Material	Amount	Total	Date	Amount
8/30/78	20'-6" ACP @	10. <u>53</u>	\$330. <u>60</u>		

DATE _____

TOWN OF LEXINGTON — BOARD OF PUBLIC WORKS

SEWER DIVISION

Sketch of Service Here

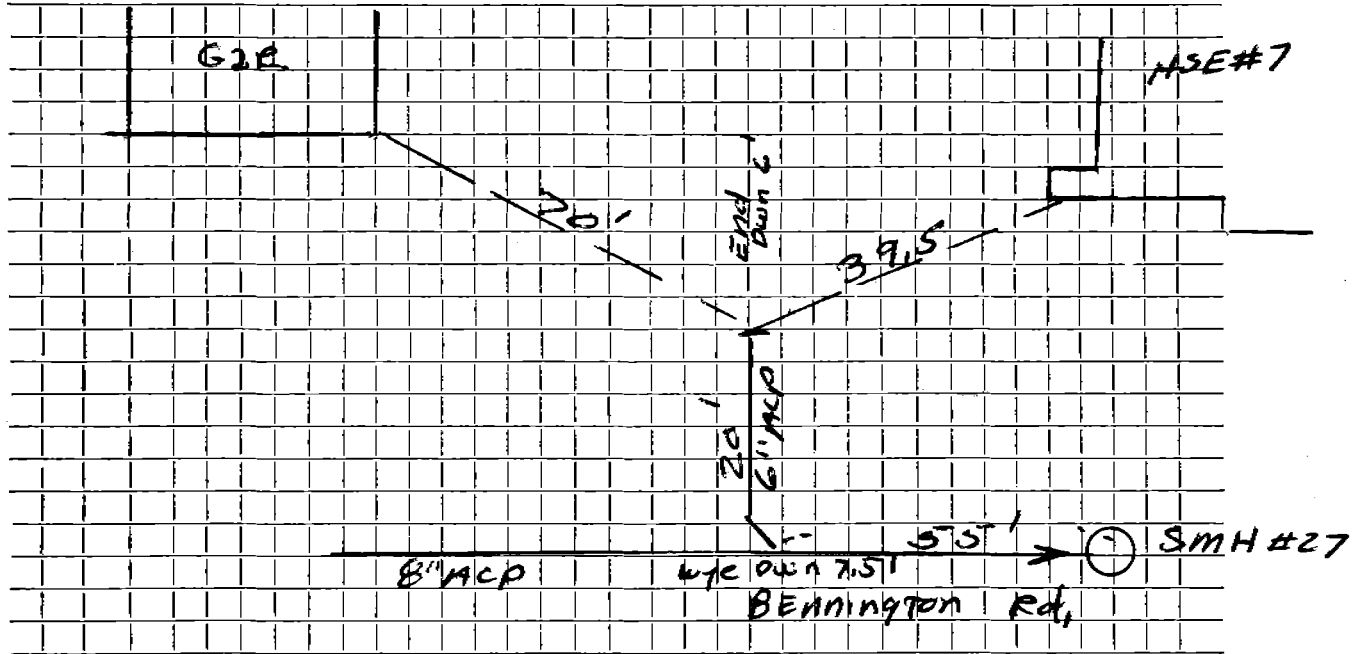

Connection made in BENNINGTON Rd. Street. Work completed

Remarks:
.....
.....