

Name

Service No.

Address

7 Bennington Rd

Location

Kind of Pipe

Size

Size of Main

Repair—Renewal—New Service

Location

Date

Material

Amount

Total

Date

Amount

10-5-00

10' - 4" PVC
31' - 6" PVC
4x6 PVC to PVC ferroco
6x4 AC to PVC ferroco
2-22° Bends

8-29-78


23' - 6" AC @ 1653

380.19

DATE _____

TOWN OF LEXINGTON — BOARD OF PUBLIC WORKS
SEWER DIVISION

Sketch of Service Here

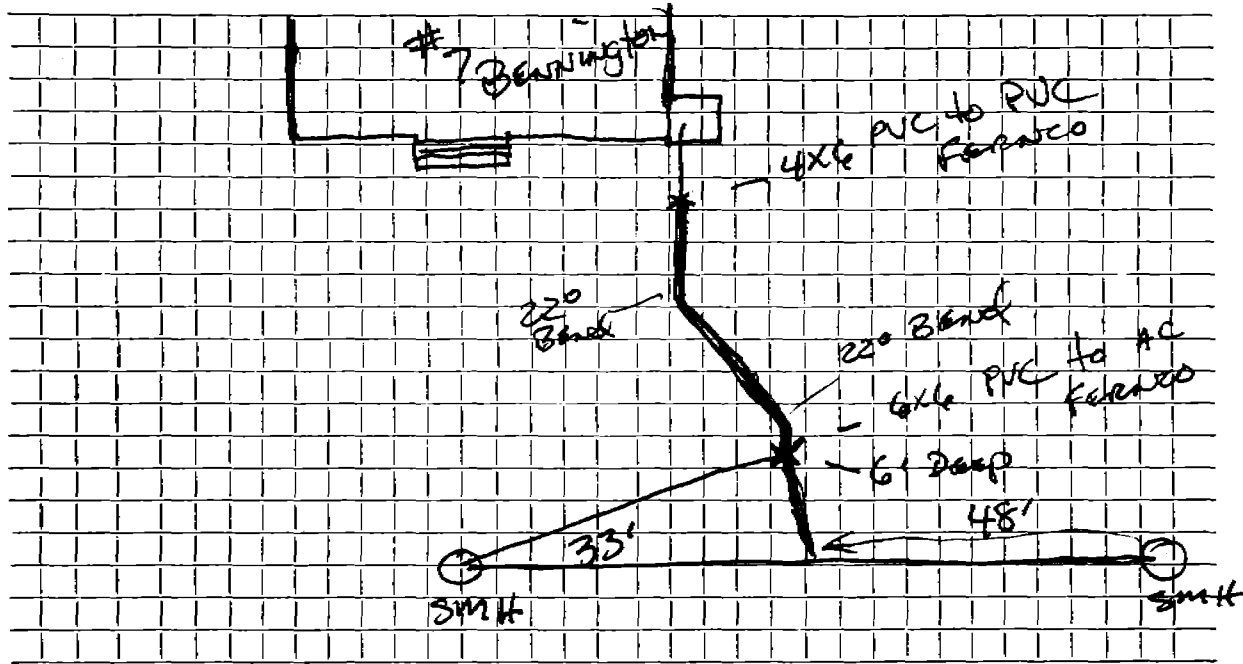

Connection made in Street. Work completed

Remarks:

.....
.....