

Name Howard H. Dawes

Service No. 101

Address 10 Bernard St.

Location

Lexington

Kind of Pipe

Size

Size of Main

~~Repair~~ ~~Renewal~~ New Service

CON. 7-13-53

Location

Date	Material	Amount	Total	Date	Amount
6/15/53	Labor	67 20		5-29-53	Deposited
	10% overhead	6 72	73 92	7-13-53	Refunded
	46'-6" Sewer Pipe @.342		15 73		
	1-6" Elbow		1 88		
	Joint Compound		2 76		
	3 Hr. Town Shovel @5.00		15 00		
	2 Hr. Trucking @.75		1 50		
			110 79		
	Labor			7-25-53	S.B.

**TOWN OF LEXINGTON—DEPT. OF PUBLIC WORKS**  
**SEWER DIVISION**

DATE.....

NO. ....


The undersigned applies for the construction of a particular sewer connecting No.....  
Street and hereby agrees to comply with the Rules and Regulations governing the construction and use of Particular  
Sewers, as now or at any future time established by the Board of Selectmen.

Am't of estimate \$ . . . . .

Am't Paid \$ . . . . .

..... Owner

**Sketch of Service Here**

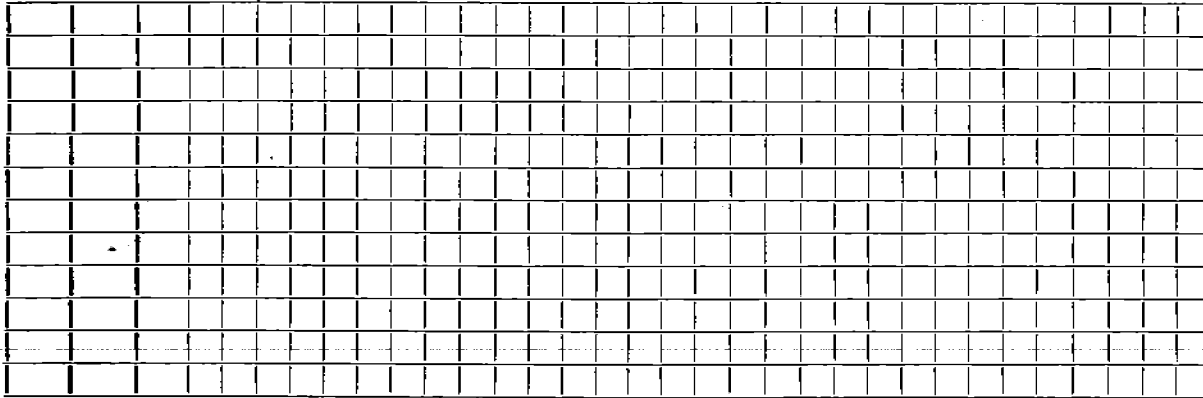

Connection made in . . . . . Street.

Work completed . . . . . 19..

Remarks: