

Name Gordon MacArthur

Service No. 41

Address 20 Bernard St.

Lexington

Location

Kind of Pipe COM. 7-13-53

Size

Size of Main

~~Repair~~ ~~Renewal~~ New Service

Location

Date	Material	Amount	Total	Date	Amount
------	----------	--------	-------	------	--------

6/10/53	Labor	67 20		8-23-53	Deposited 125 -
	10% overhead	6 72	73 92	7-13-53	Refunded 11 89
	14'-6" Sewer Pipe @.342		15 05		113 11
	Joint Compound		2 64		
	4 Hr. Town Shovel @5.00		20 00		
	2 Hr. Trucking		1 50		
			113 11		

Labor

**TOWN OF LEXINGTON—DEPT. OF PUBLIC WORKS**  
**SEWER DIVISION**

DATE.....

NO. ....

The undersigned applies for the construction of a particular sewer connecting No.....  
Street and hereby agrees to comply with the Rules and Regulations governing the construction and use of Particular  
Sewers, as now or at any future time established by the Board of Selectmen.


Am't of estimate \$.....

Am't Paid \$.....

..... Owner

---

**Sketch of Service Here**

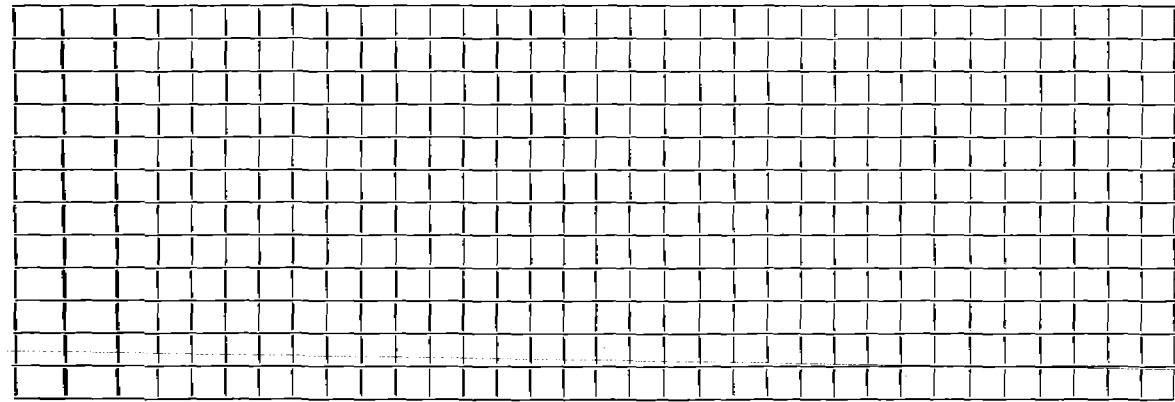

Connection made in .....

Street.

Work completed.....19..

Remarks: