

Name **Ralph J. Frissore**

Service No. **81**

Address **22 Bernard Street**

Lot **#186**

Location **Lot # 186**

Kind of Pipe

Size

Size of Main

~~Repair - Renewal~~ **New Service**

Location **Comm 10-19-59**

Date	Material	Amount	Total	Date	Amount
------	----------	--------	-------	------	--------

25' 6" V.C. Sewer Pipe

6-10-59

Deposit

210.00

Installed by Cont. @3.00 per ft.

75.00

10-19-59

Refund

26.75

Billed when connected

173.22

6-12-59

Labor

47.11

10% O.H.

4.71

51.82

37' 6" Transite Pipe @.70

25.90

2 hrs. Town Shovel @6.50

13.00

2 hrs. Trucking @.75

1.50

1 hr. Trucking @3.00

3.00

1 hr. Trailer @3.00

3.00

173.22

Labor

TOWN OF LEXINGTON—DEPT. OF PUBLIC WORKS
SEWER DIVISION

DATE.....

NO.


The undersigned applies for the construction of a particular sewer connecting No.....
Street and hereby agrees to comply with the Rules and Regulations governing the construction and use of Particular
Sewers, as now or at any future time established by the Board of Selectmen.

Am't of estimate \$.....

Am't Paid \$.....

..... Owner

Sketch of Service Here

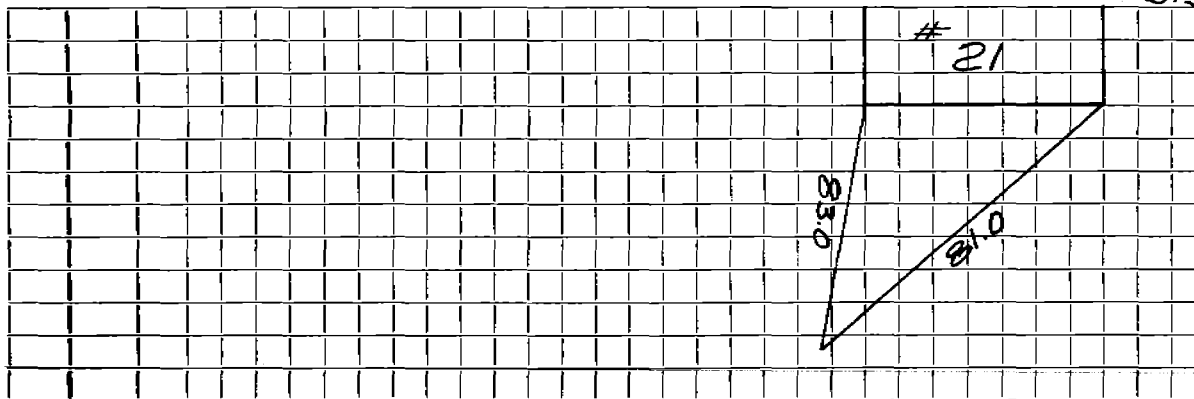

S.S. For # 22

Connection made in Street.

Work completed.....19..

Remarks: