

Name **Thomas Névin**

Service No. **165**

Address **26 Bernard Street**

**Location**

**Kind of Pipe**

**Size**

**Size of Main**

~~Repair~~ ~~Renewal~~ **New Service COM.11-9-53**

**Location**

Date	Material	Amount	Total	Date	Amount
10/5/53	Labor	64 00		9-21-53	125 00
	10% overhead	6 40	70 40	11-9-53	10 45
	52' - 6" sewer pipe @ .3036		15 79		114 50
	1 - 6" - 1/8 bend		1 24		
	joint compound		3 12		
	3 hrs. Littlefield shovel @ 7.50	22 50			
	2 hrs. trucking @ .75		1 50		
6-18-91			114 55		
	29' 6" PVC				
	1 6" Fernco				
	Labor			7-15-81	May be blocked at 1500
				10-9-81	& clay connection
					R.O.

TOWN OF LEXINGTON—DEPT. OF PUBLIC WORKS  
SEWER DIVISION

DATE .....

NO. ....


The undersigned applies for the construction of a particular sewer connecting No. ....  
Street and hereby agrees to comply with the Rules and Regulations governing the construction and use of Particular  
Sewers, as now or at any future time established by the Board of Selectmen.

Am't of estimate \$ .....

Am't Paid \$ .....

..... Owner

Sketch of Service Here **26**

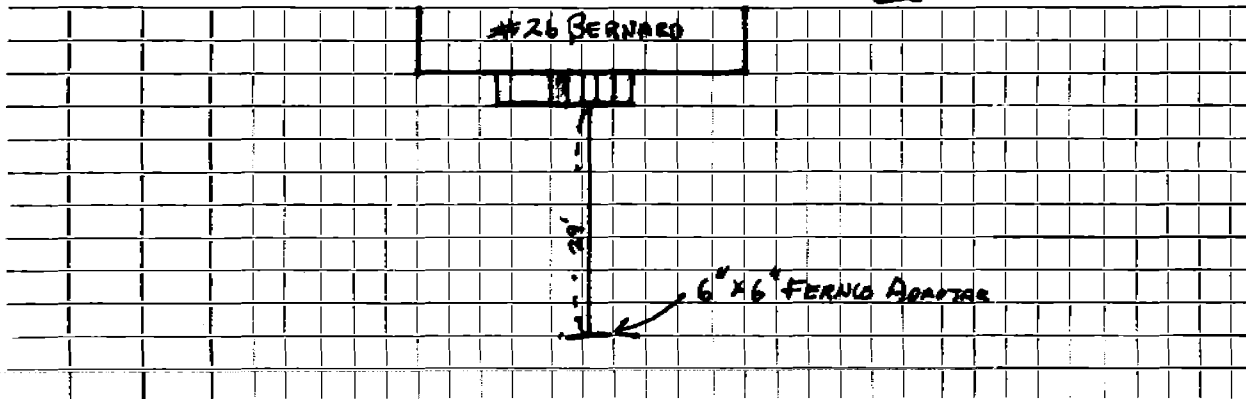

Connection made in ..... Street.

Work completed ..... 19..

Remarks: